

SECTION PLAT

G-3873

15

Section 5 21 & 28

Township 34S


Range 19E W.M.

42419

County of LAKE

State of ORE

NORTH

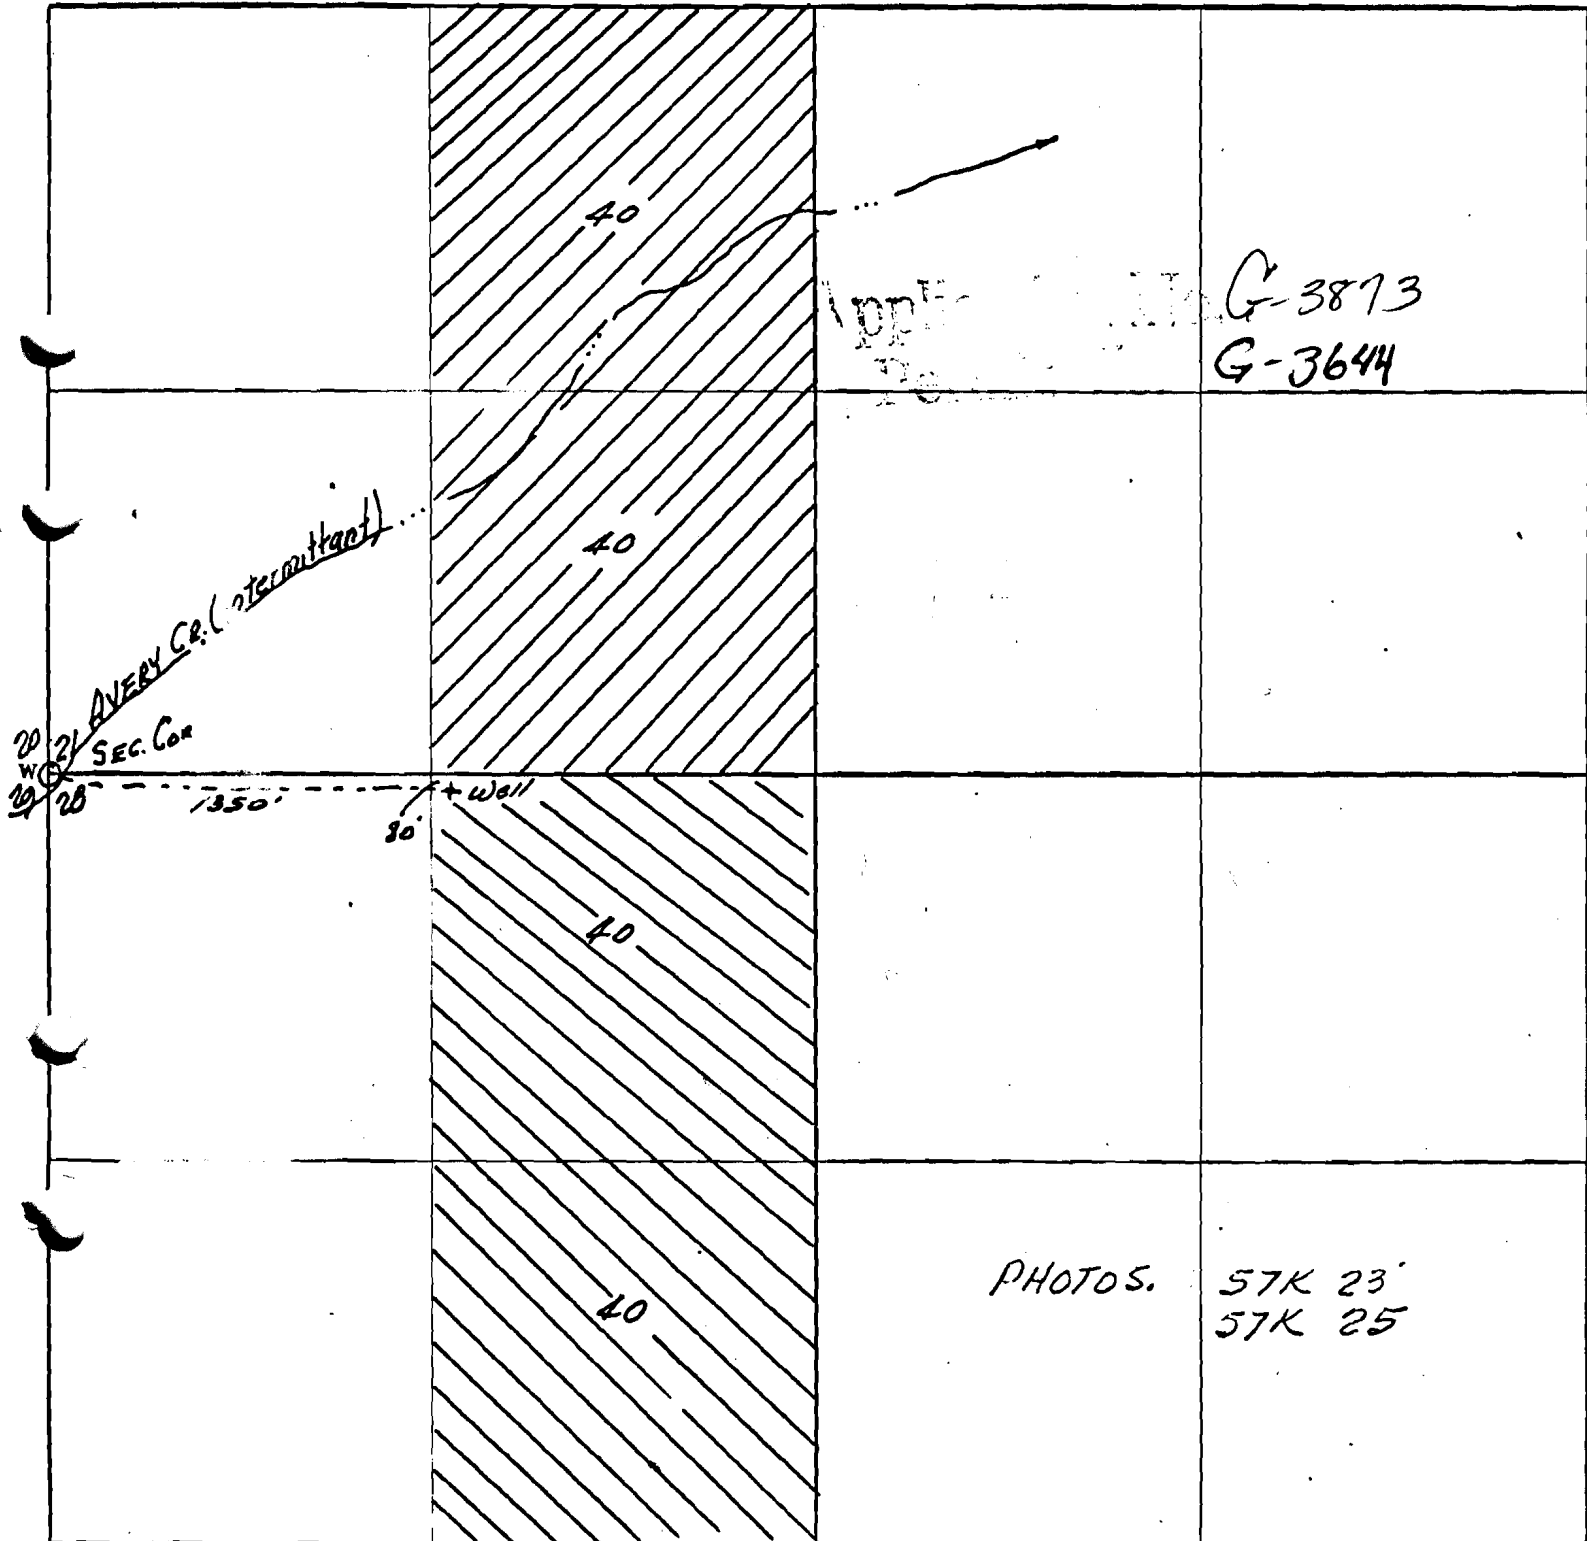

Remarks (scale - 8" = 1 mile - 660) - Map to accompany the application of Howard H Gilson and Dennis R Gilson (a partnership) to appropriate water from a well for irrigation purposes, in Secs. 21 & 28 T34S R.19E.W.M. PAISLEY Oregon