# T.4S. R.2&3W. W.M.

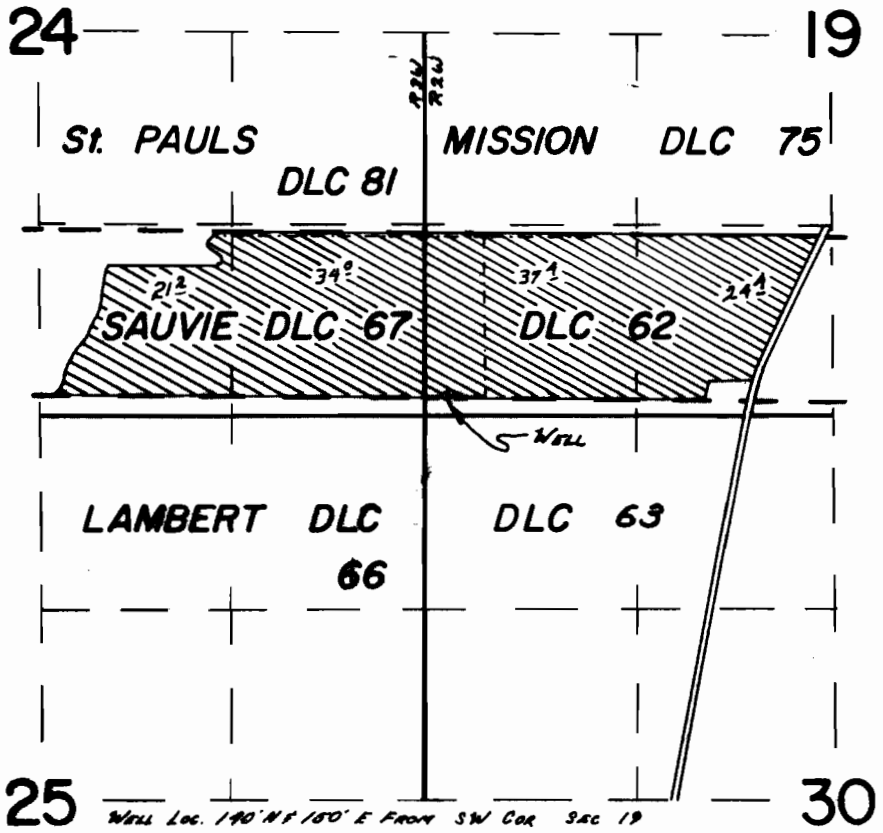


## FINAL PROOF SURVEY
UNDER

Application No. G-4386 Permit No. G-4138
IN NAME OF

COLEMAN FARMS, INC.

Surveyed MAY 15 1979, by R. B. MUCKEN

DRW-GLL-180 1/1P TJP