


T.5&6S. R.I.W. W.M.

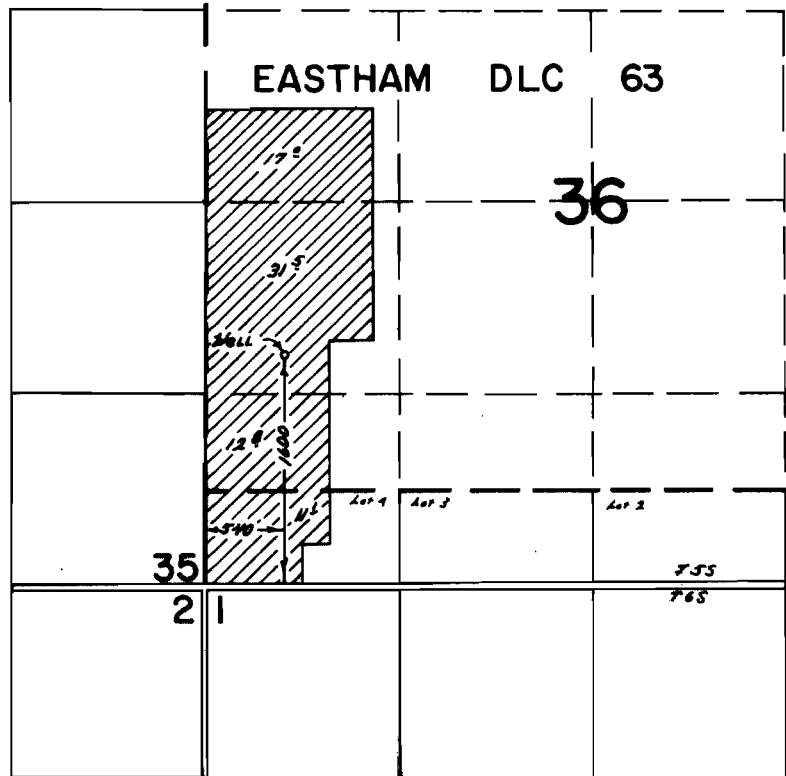

FINAL PROOF SURVEY UNDER

Application No. G-1898 Permit No. G-1617
IN NAME OF

AVERIAN SHADRIN

Surveyed May 21 1972, by T J Paul