


# T. 8 S. R. 1 W. W. M.

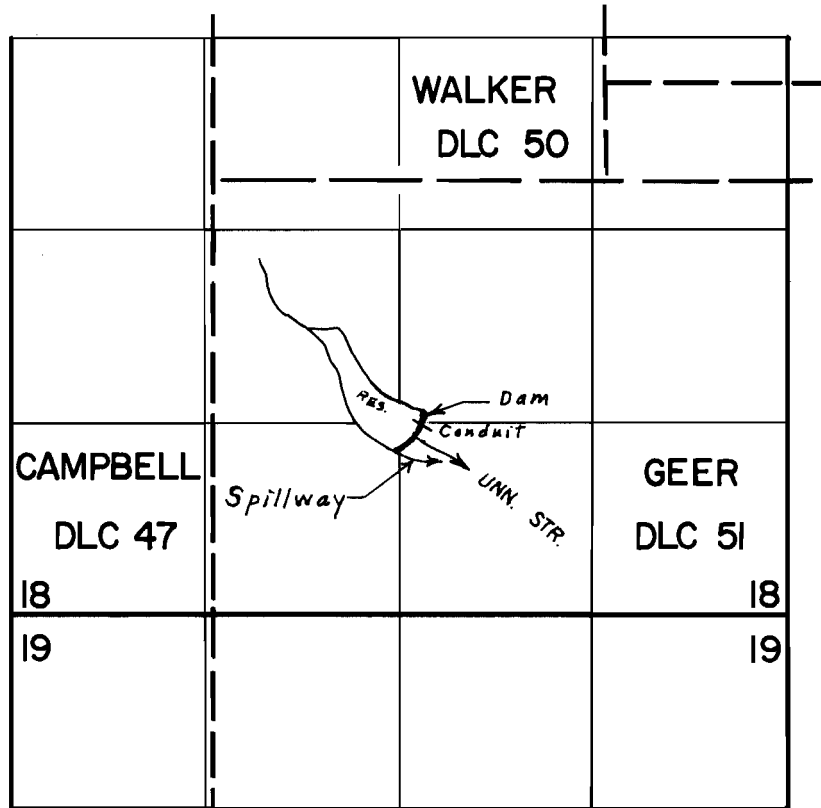

Div. Pt. located 1760' S. & 1370' E. from N.W. Cor. Geer D.L.C. 51

## FINAL PROOF SURVEY UNDER

Application No. R-44896 Permit No. R-5138

IN NAME OF

MR. & MRS. PAUL GOLLIDAY

Surveyed MAY 18 1973, by L.E. GOULD