


G-3238
42427

T.3N. R.23E. W.M.

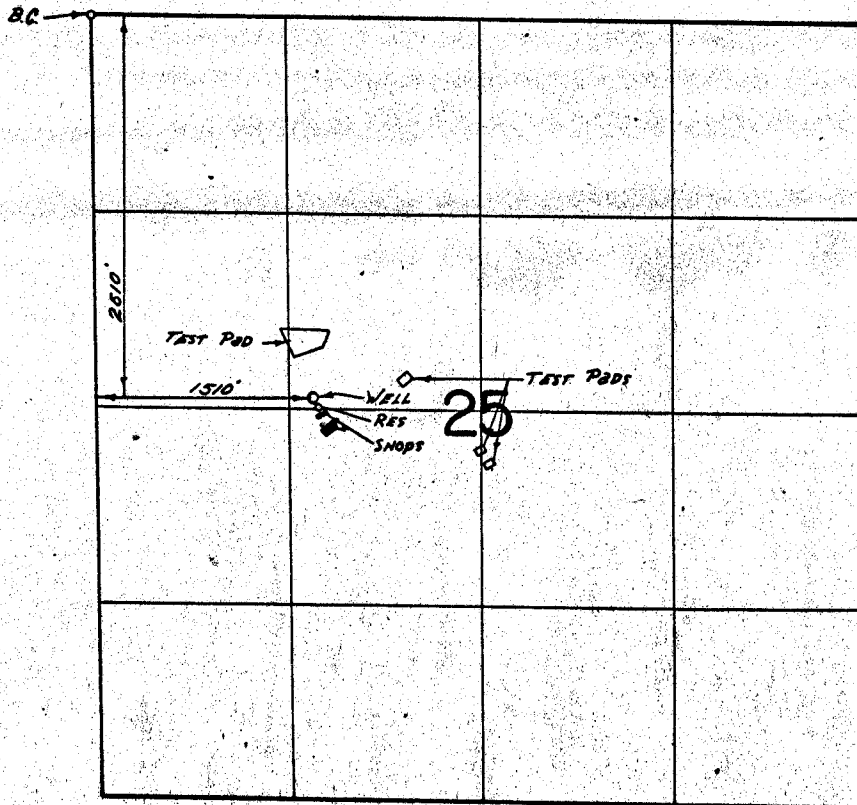

FINAL PROOF SURVEY
UNDER

Application No. G-3581 Permit No. G-3238
IN NAME OF

THE BOEING COMPANY

Surveyed APRIL 17 1974, by T. J. PAUL