


G-4097

42428

T.1N. R.27E. W.M.

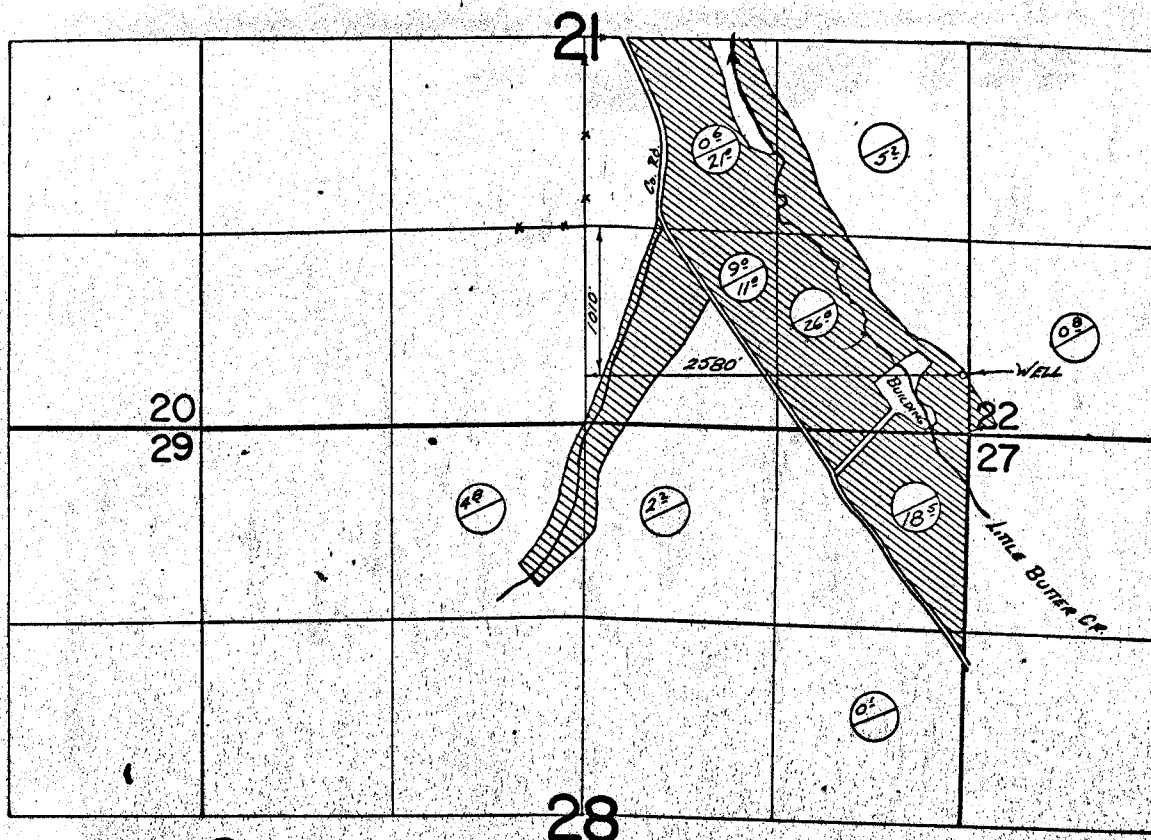

— PRIMARY
- - - SUPPLEMENTAL

FINAL PROOF SURVEY
UNDER

Application No. G-4340 Permit No. G-4097
IN NAME OF

CHARLES DALY

Surveyed APRIL 17, 1924, by T. J. Pall