


G-4133
42429

T.3S., R.26E., W.M.

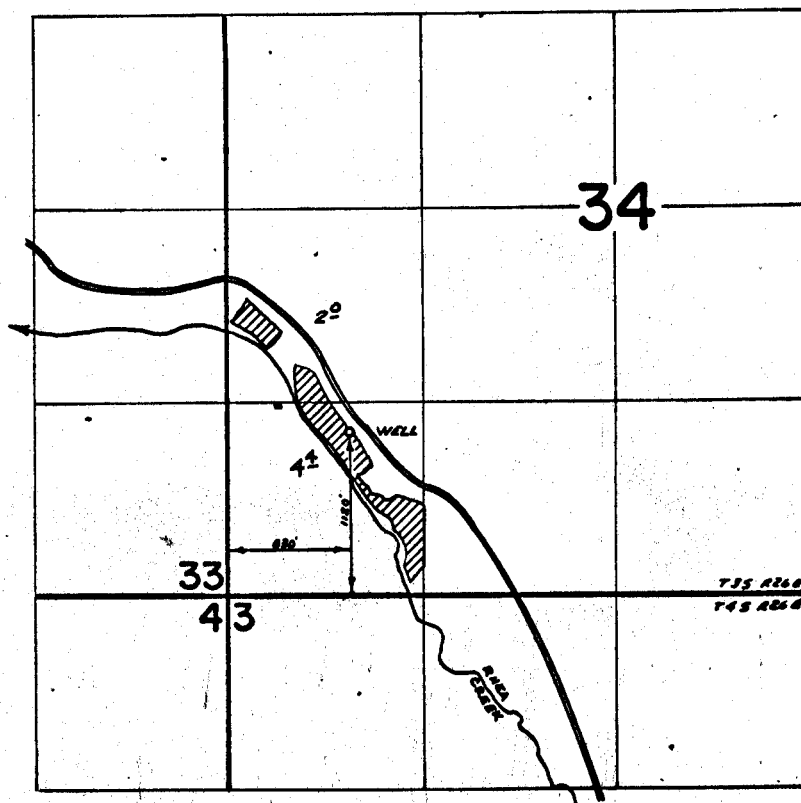

FINAL PROOF SURVEY
UNDER

Application No. G-4448 Permit No. G-4133
IN NAME OF

DALLAS McDANIEL

Surveyed May 13, 1974, by D. Dorby