


G-4190  
42436

T.4S., R.26E., W.M.

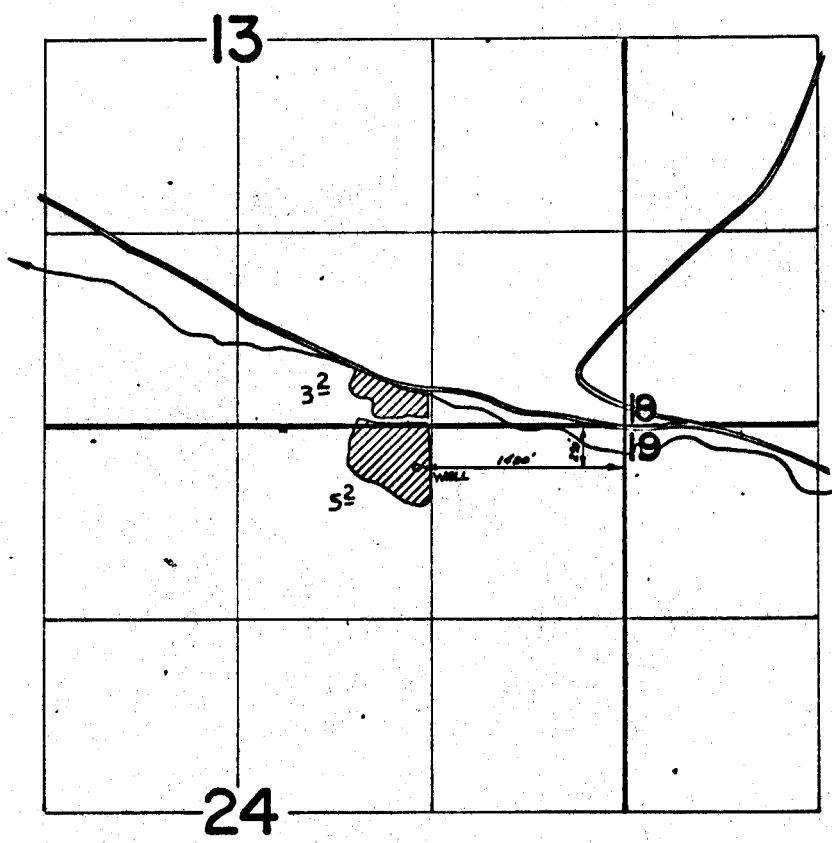

**FINAL PROOF SURVEY**  
UNDER

Application No. G-4444 Permit No. G-4190  
IN NAME OF

DALLAS AND ZELMA McDANIEL

Surveyed May 13 1974, by David Torby