


G-4281

42433

T. 2 N., R. 26 E., W.M.

CANCELLED
V44 P290
T-6387

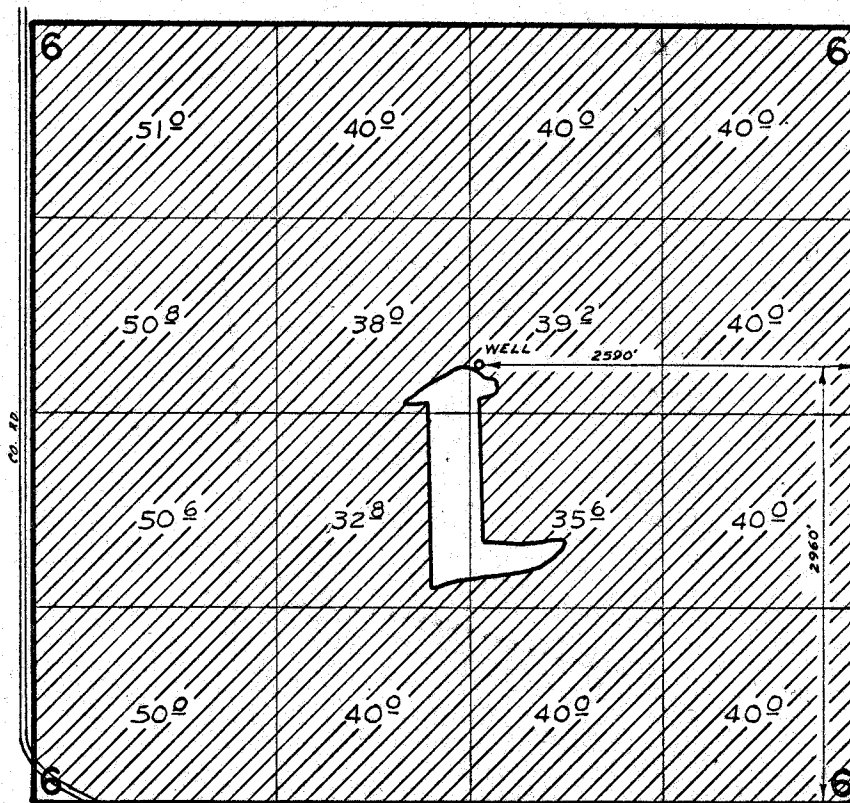

FINAL PROOF SURVEY
UNDER

Application No. G-4557 Permit No. G-4281
IN NAME OF

JERALD E. REA

Surveyed April 17, 1974, by D. Naesly