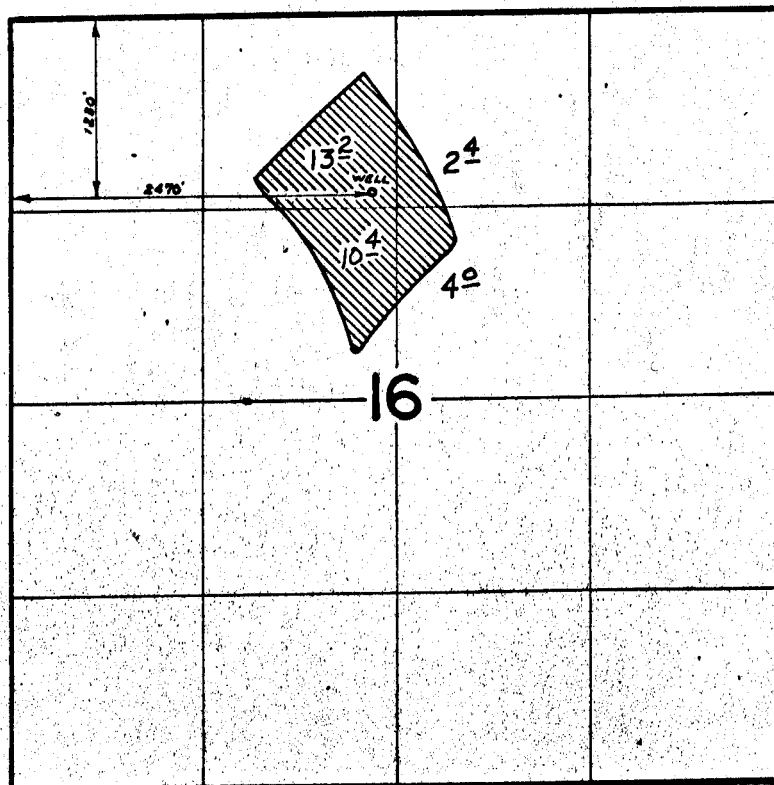


T.5S., R.25E., W.M.

**FINAL PROOF SURVEY**
UNDERApplication No. G-5013 Permit No. G-4726
IN NAME OFDORRIS L. GRAVESSurveyed May 13 1974, by *D. Dorby*