


T.3S. R.17E. W.M.

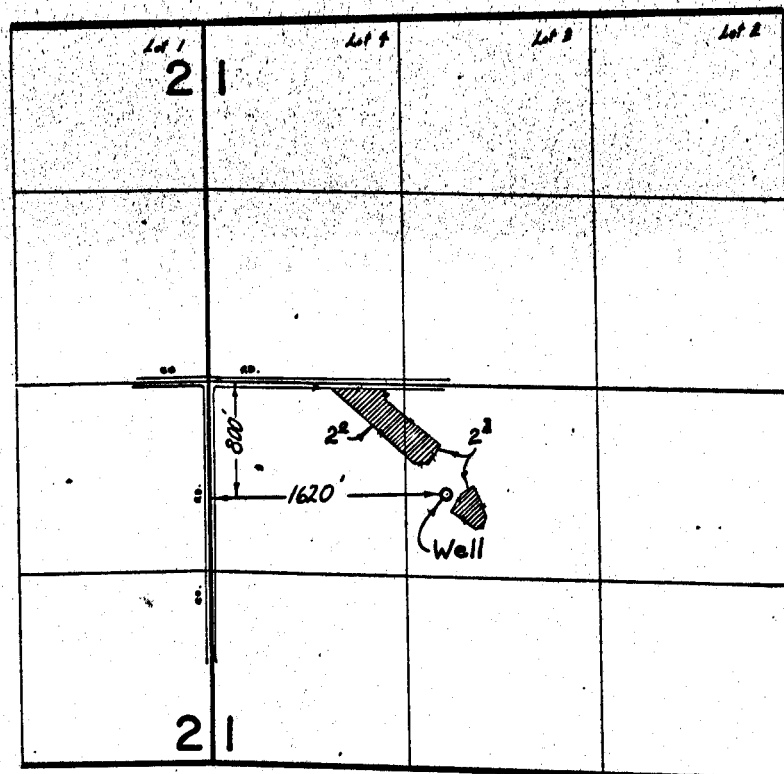

FINAL PROOF SURVEY
UNDER

Application No. G-3911 Permit No. G-3674
IN NAME OF

OWEN C. EAKIN

Surveyed APRIL 2, 1974, by L. E. GOULD