
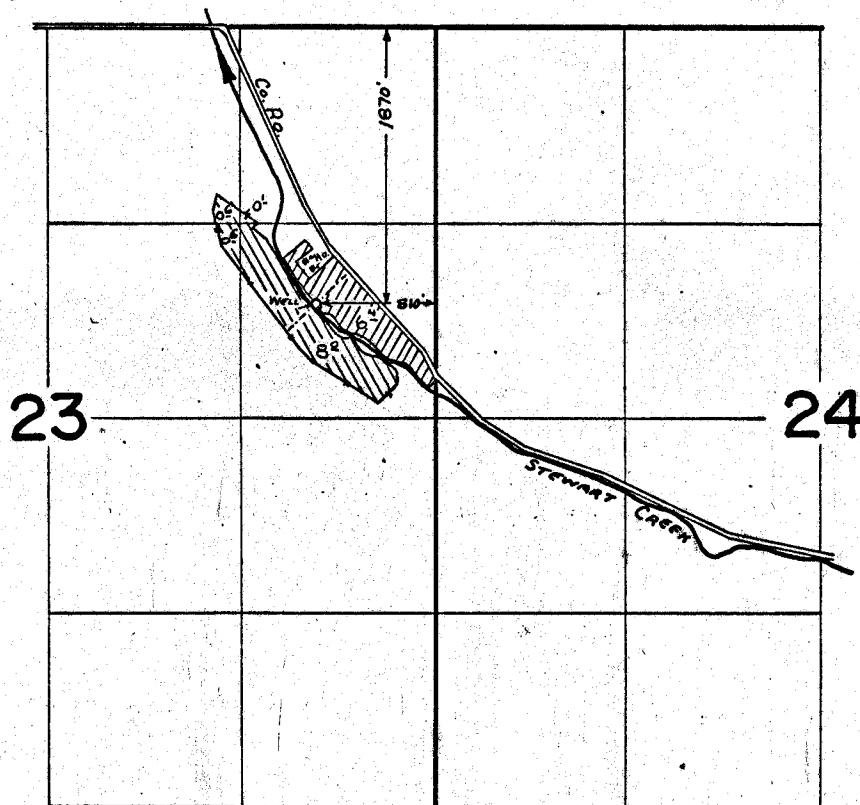



G-3763
42438

T. 1 S., R. 32 E., W.M.

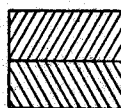

 - PRIMARY
 - SUPPLEMENTAL

FINAL PROOF SURVEY UNDER

Application No. G-4011... Permit No. G-3763.
IN NAME OF

.....HILMER...HORN.....

Surveyed Aug. 7... 1974, by ...L. Toll.....