


G-4059  
42439

T.5N., R.28E., W.M.

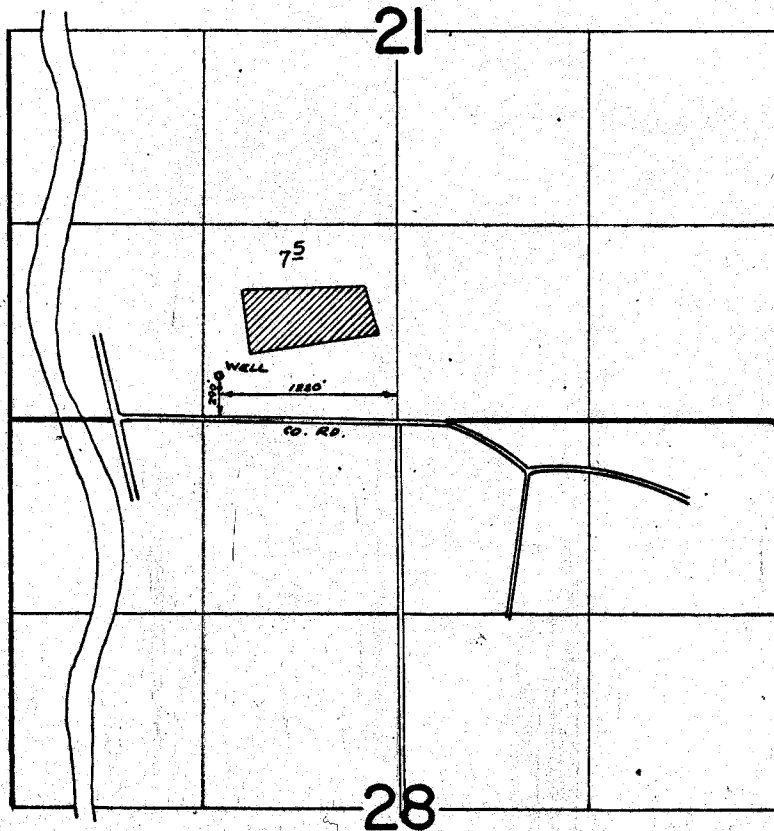

**FINAL PROOF SURVEY**  
UNDER

Application No. G-4297 Permit No. G-4059  
IN NAME OF

CLYDE J. NOBLES

Surveyed April 16 1974, by D. Dorby