


T.1S. R.39E. W.M.

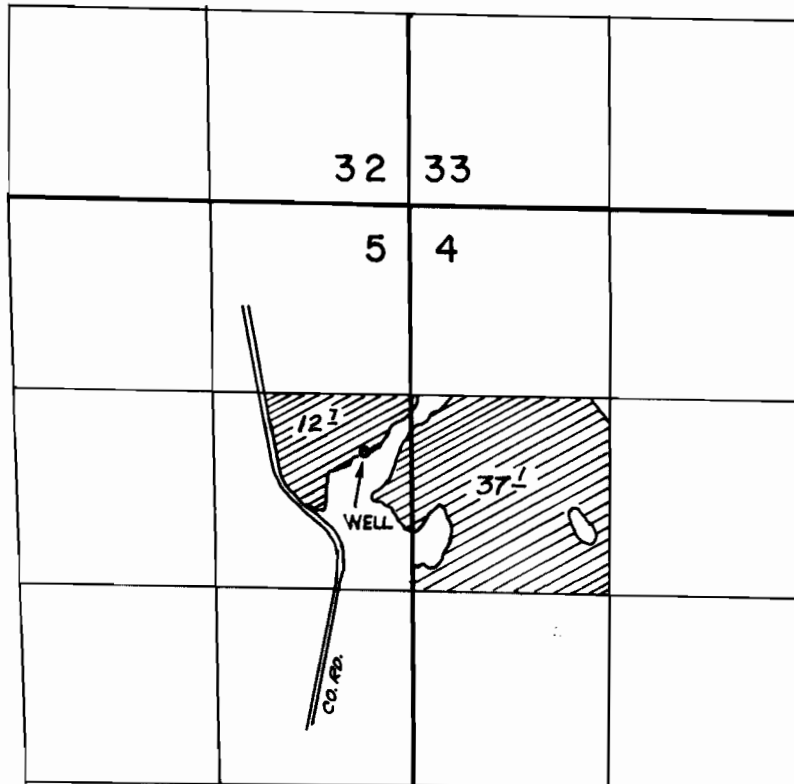

WELL - 940' N, 300' W FROM E 1/4 CORNER SECTION 5

FINAL PROOF SURVEY
UNDER

Application No. G-3941 Permit No. G-3698
IN NAME OF

RUSSELL HUG

Surveyed July 12 1973, by R. MUCKEN