


T.1N.,R.39E.,W.M.

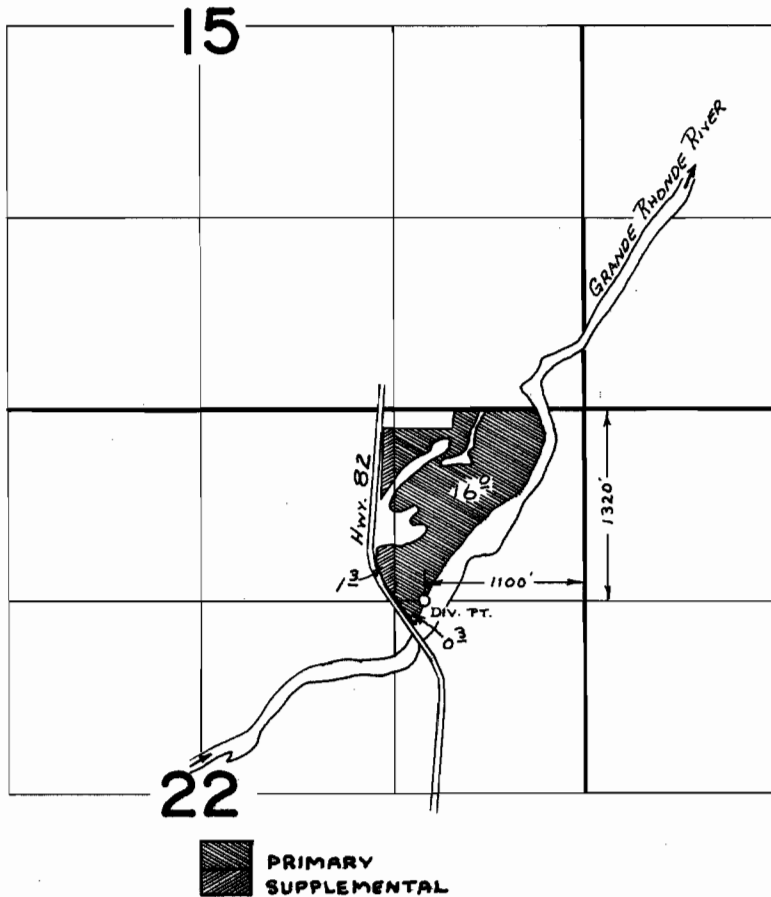

FINAL PROOF SURVEY UNDER

Application No. 47995 Permit No. 35997....
IN NAME OF

PAUL SLAUGHTER

Surveyed SEPT. 12 1974, by L. H. NUNN....