


T.1&2N. R.40E. W.M.

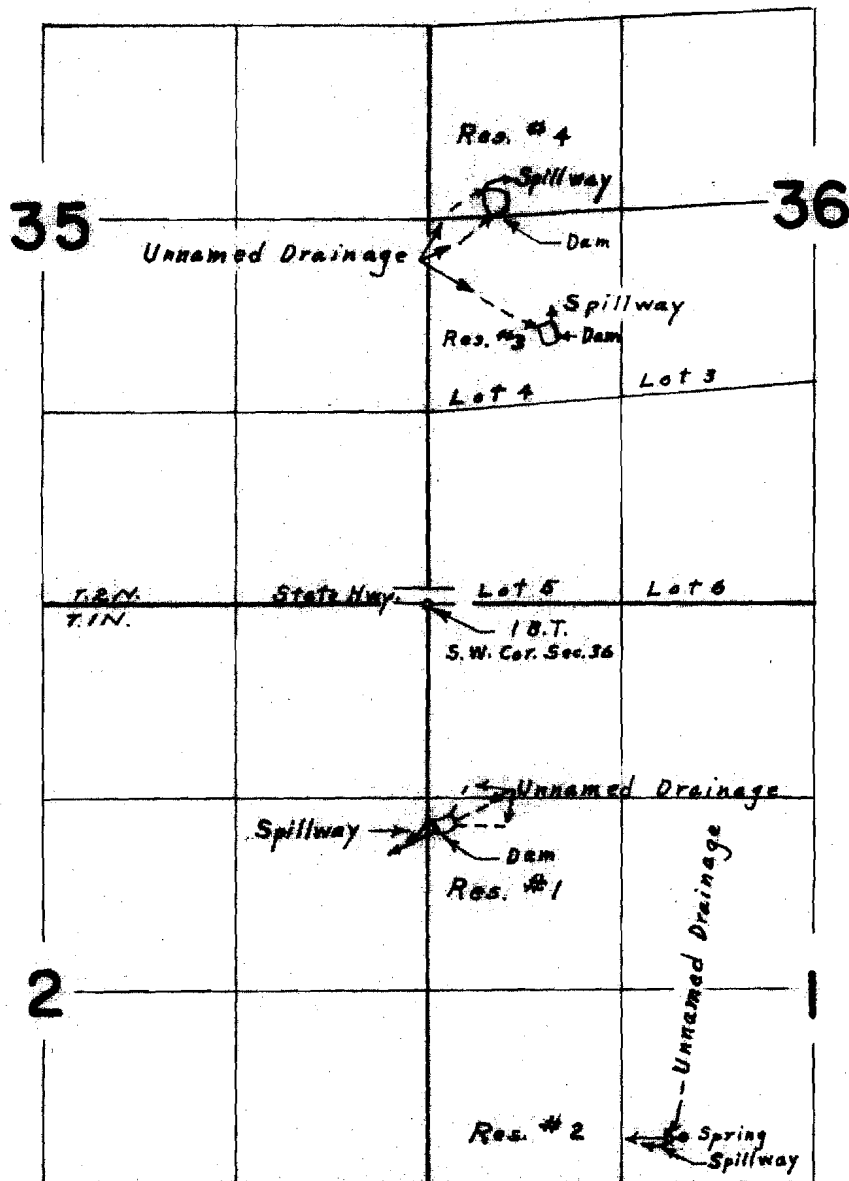

FINAL PROOF SURVEY
UNDER

Application No. R-41803 Permit No. B-4796.
IN NAME OF

R. K. WALLER

Surveyed Aug. 4, 1973, by L. E. Gould.

27

26

34

35

Q. M. #5

Q. M. #6

Inlet & Outlet
Unnamed Drainage

Dam

Res. #6

Pt. on Sec. Line

187.
State Hwy.