


T.5S.R.11E.W.M.

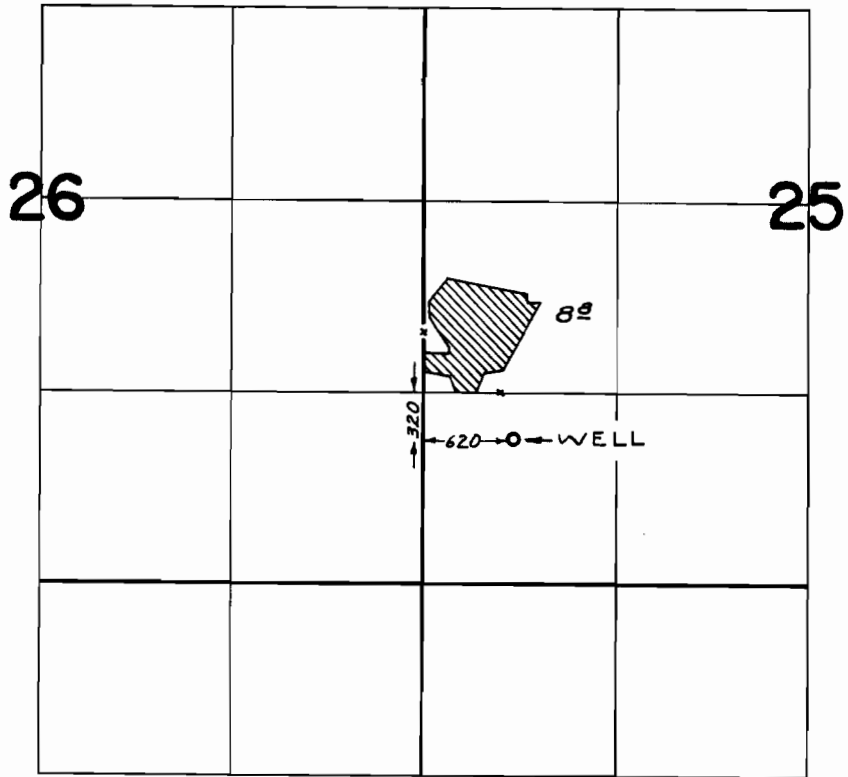

FINAL PROOF SURVEY
UNDER

Application No. G-4805 Permit No. G-4530
IN NAME OF

GEORGE H. HARMON

Surveyed SEPT. 13, 1974, by D. NORBY