


T.1N.R.12E.W.M.

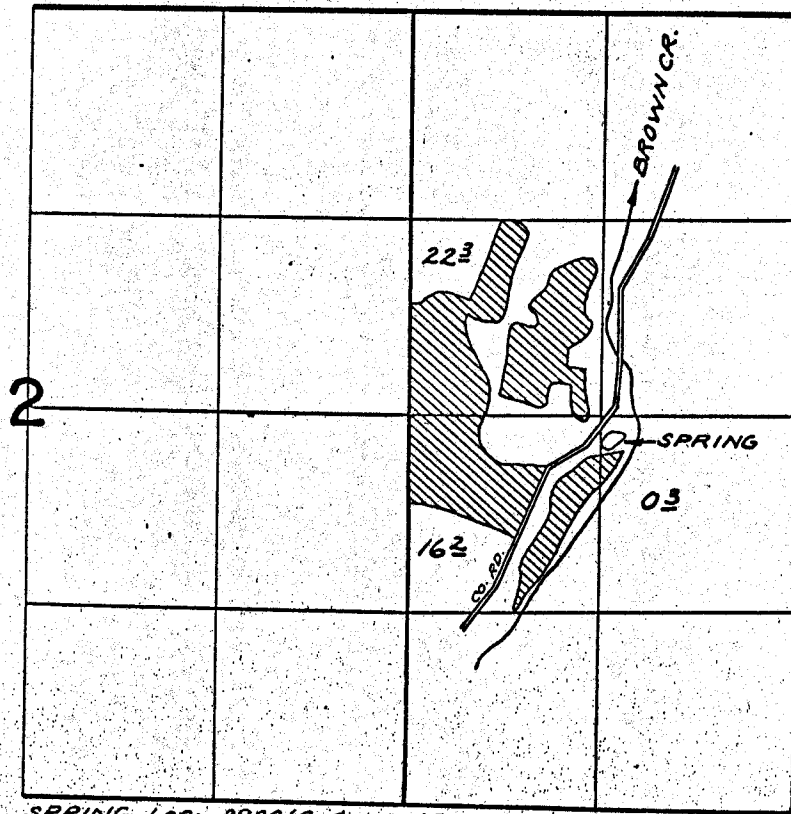

SPRING LOC: 2900'S. & 1400'E. FROM NW COR. SEC. 1

FINAL PROOF SURVEY
UNDER

Application No. 40086..... Permit No. 29871.....
IN NAME OF

VIRGIL M. ELLETT

Surveyed APR. 24, 1974, by D. NORBY