
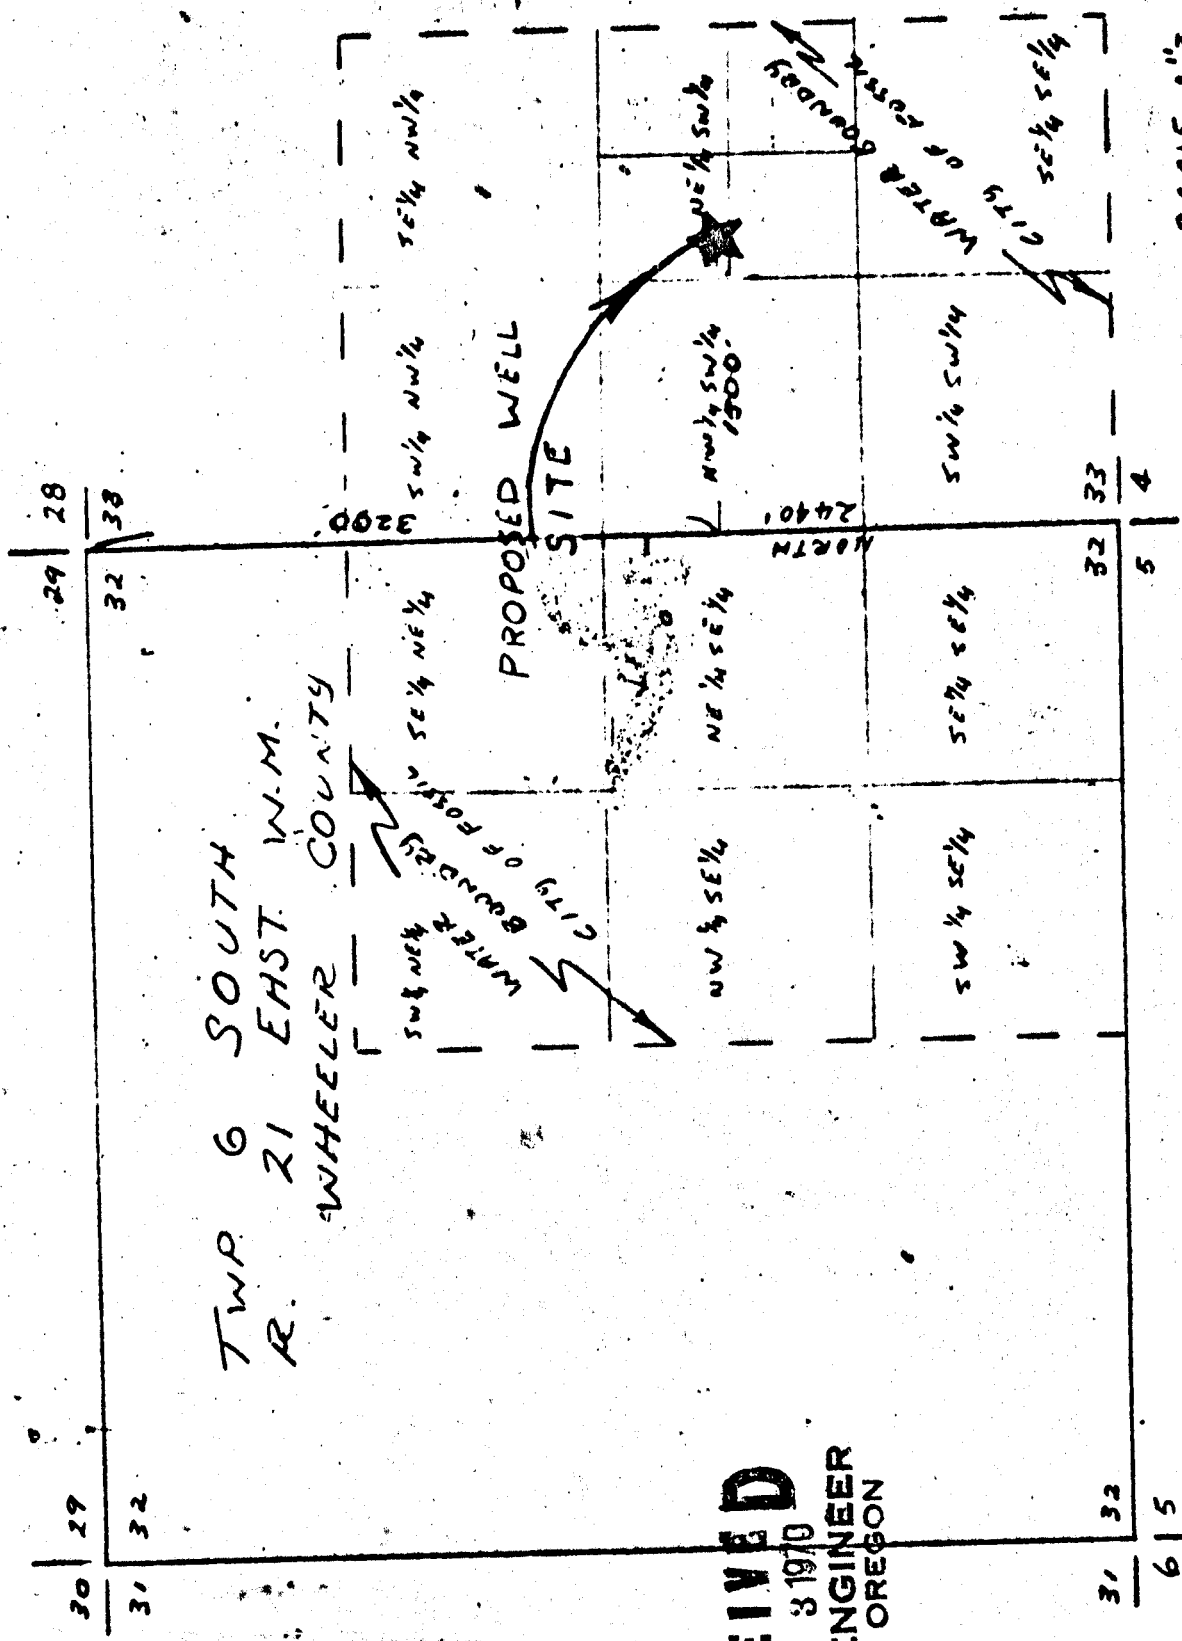


BY..... DATE.....
CHKD. BY..... DATE.....

SUBJECT.....

JOB NO. **G 4862**
42451

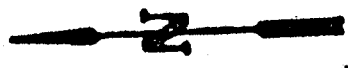

SCALE 1" = 1000'
DATE 12-1-70

RECEIVED
DEC 3 1970
STATE ENGINEER
SALEM, OREGON

Application No. **G-5124**
Permit No. **G-4862**

6 | 5