


T.9S. R.25E. W.M.

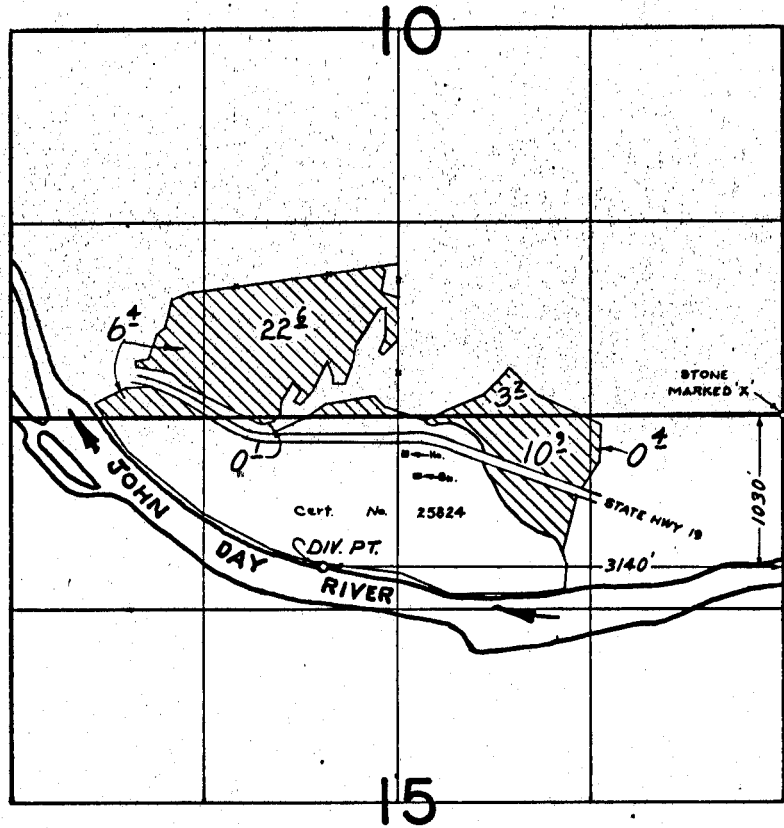

**FINAL PROOF SURVEY**  
UNDER

Application No. 39103 Permit No. 29340  
IN NAME OF C 42453

CHARLES H. HILL

Surveyed JUNE 5, 1974, by L.E. GOULD