


T.6S.R.20E.W.M.

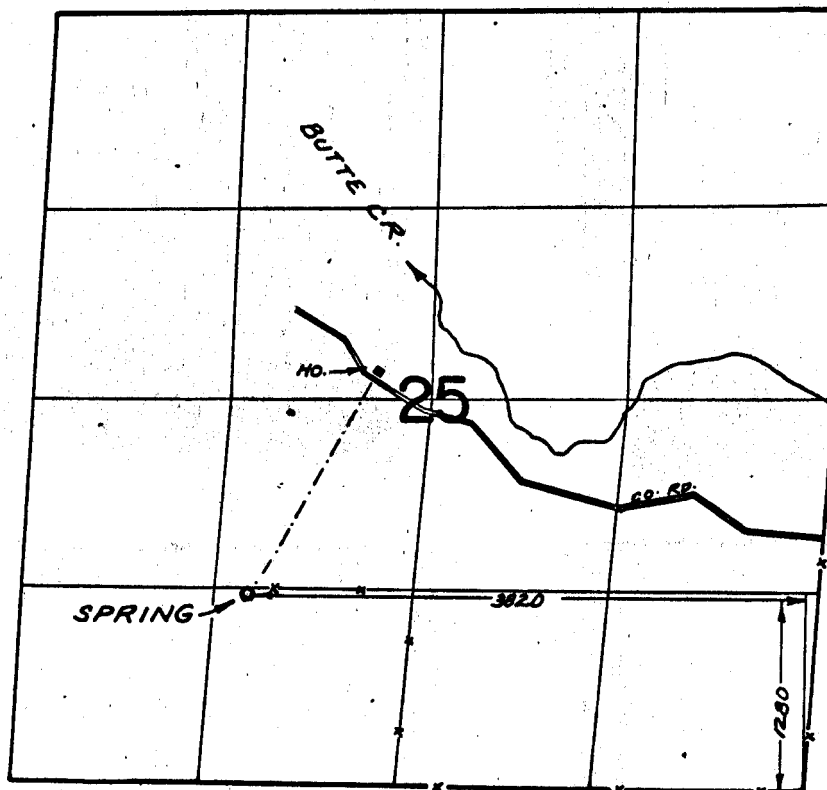

FINAL PROOF SURVEY
UNDER

Application No. 44199..... Permit No. 33021.....
IN NAME OF

.....HARRY & FLORENCE ZACHARY.....

Surveyed July 15, 1974, by R. MUCKEN