


T.9S.,R.22&23E.,W.M.

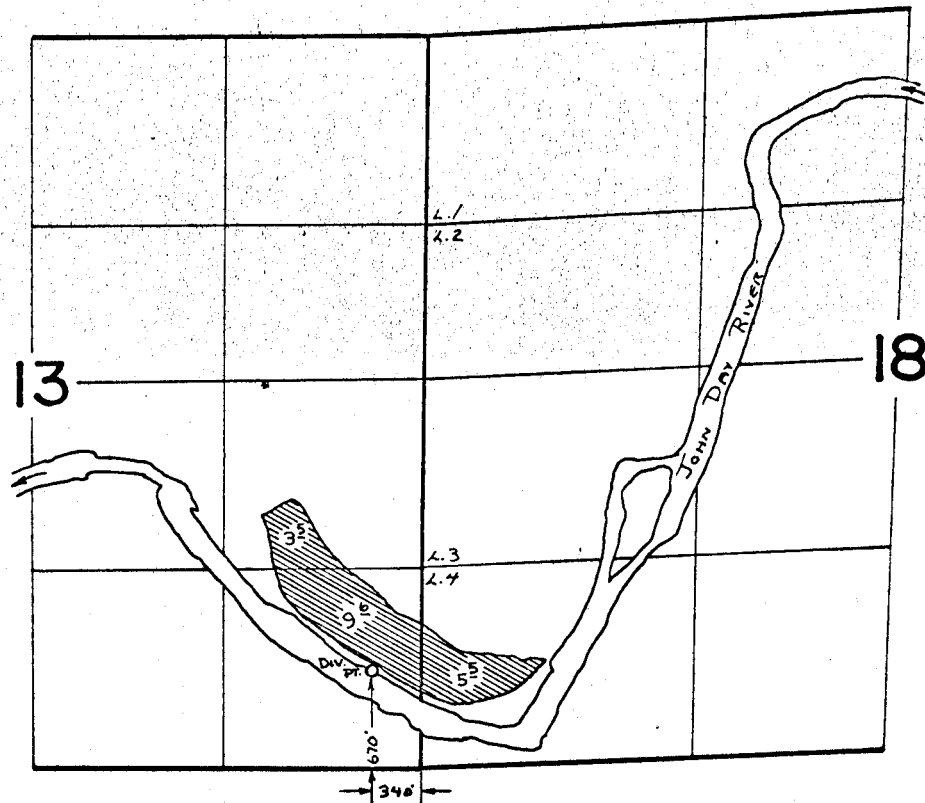

FINAL PROOF SURVEY
UNDER

Application No. 44679 Permit No. 33450
IN NAME OF Cart. 42456

FRANK SMITH FUSSNER

Surveyed Aug. 8, 1974, by L.H. NUNN