


T.12S.R.44E.W.M.

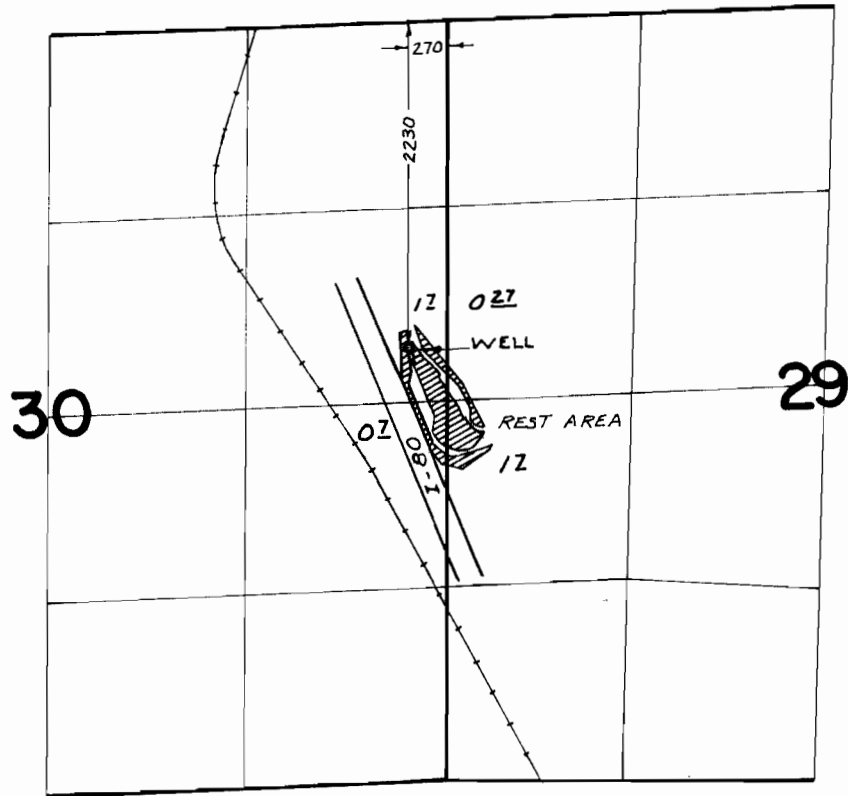

FINAL PROOF SURVEY
UNDER

Application No. G-4022 Permit No. G-3775
IN NAME OF

OREGON STATE HIGHWAY COMMISSION

Surveyed AUG. 7, 1974, by R. MUCKEN.