


T.9S. R.44E. W.M.

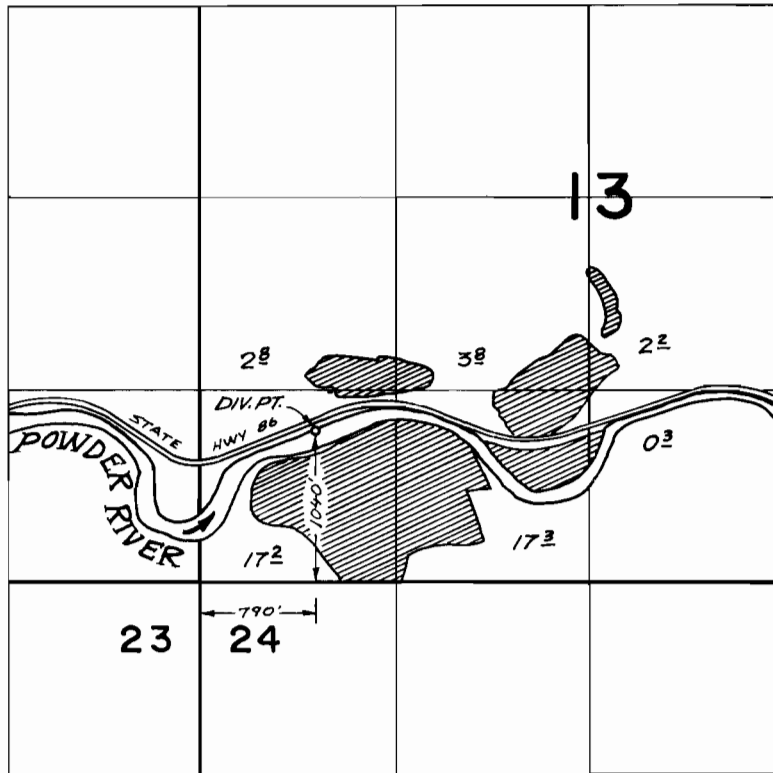

FINAL PROOF SURVEY UNDER

Application No. 43373 Permit No. 32417
IN NAME OF

GRANT SHOLD

Surveyed OCT. 28 1974, by L.M.TOLL