


# T. 6 & 7 S. R. 41 E. W.M.

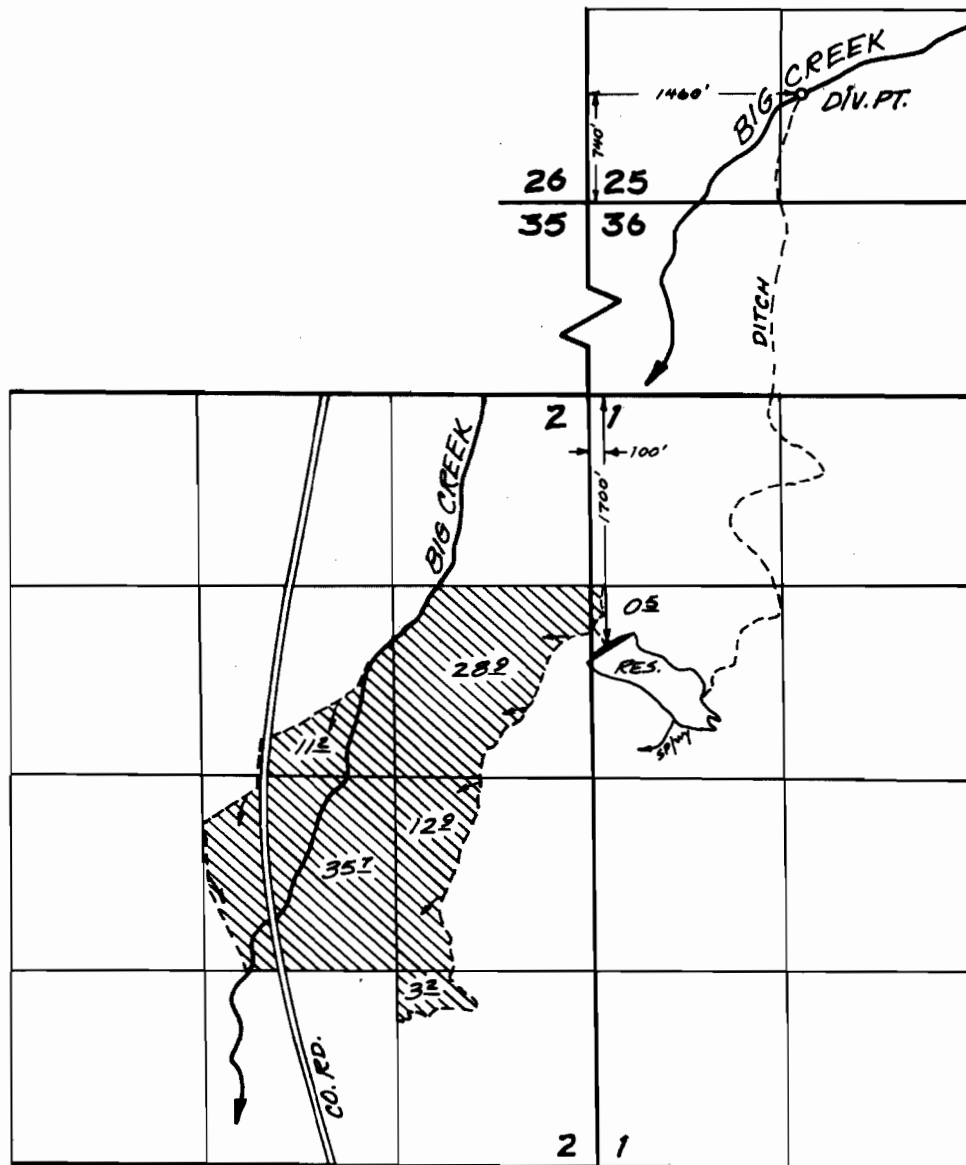

## FINAL PROOF SURVEY UNDER

Application No. R 43340 43341 Permit No. R 5031 52745  
IN NAME OF

ROBERT W. WIRTH

Surveyed OCT. 25 1974, by L.M. TOLL