T. 12 S. R. 5 W. W. M.

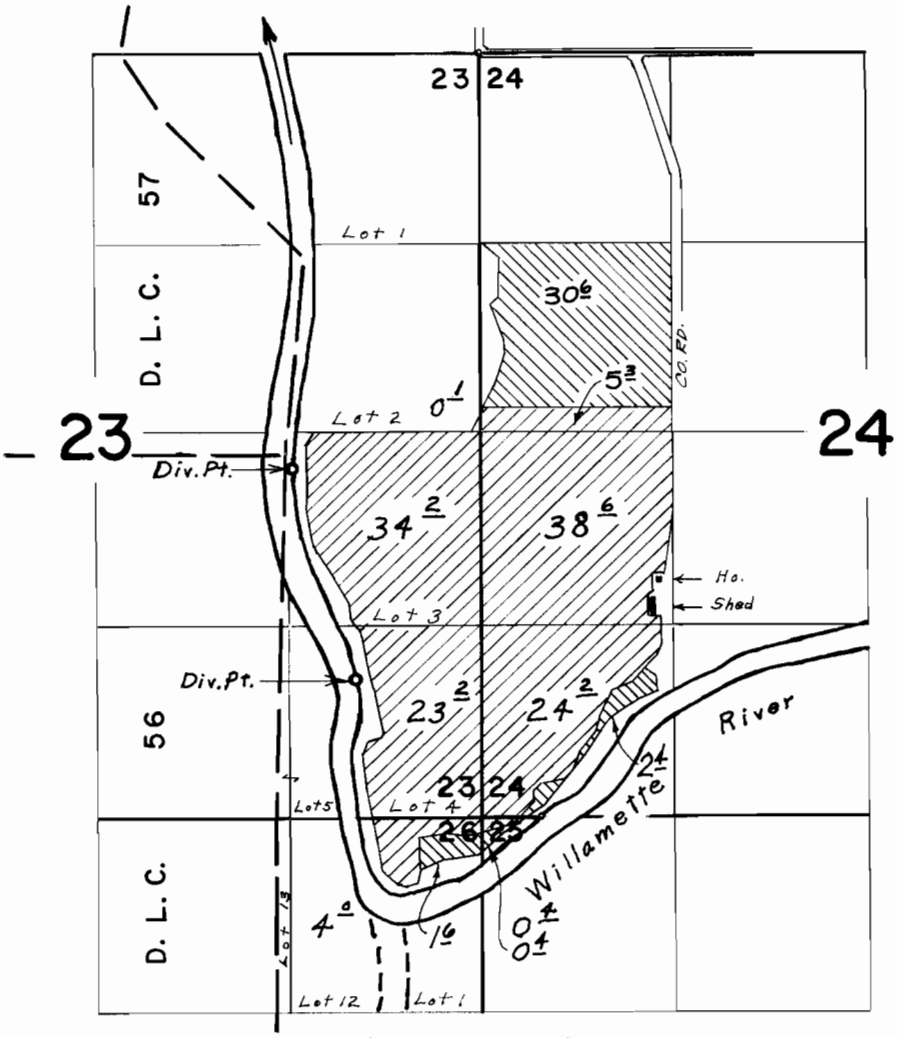

Div. Pts. located; 2850'S. & 1280' W., 4300'S. & 860' W. both from N.E. Cor. Sec. 23

FINAL PROOF SURVEY
UNDER

46631 34845

Application No. 41860 Permit No. 31321

IN NAME OF

ROBERT E. GISLER

Surveyed Oct. 28, 1969, by L. E. Gould
NOV. 4, 1974 by L.M. TOLL

DFJ 2LL 41 PTS 1974 W P.T.S. - 1969 W