


T.12S., R.6W., W.M.

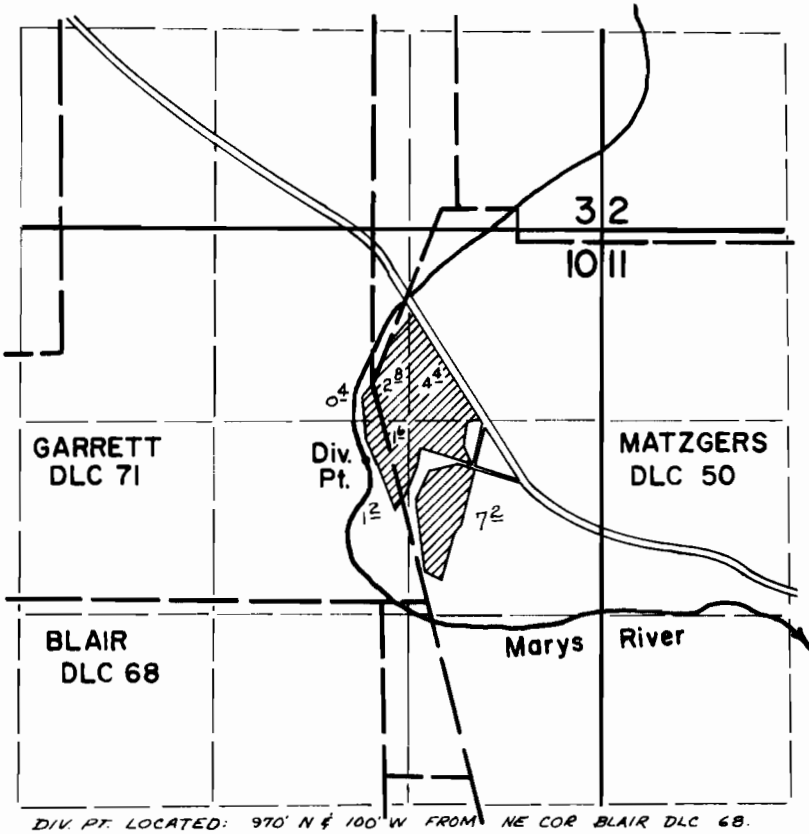

FINAL PROOF SURVEY
UNDER

Application No. 46701 Permit No. 34898
IN NAME OF

OTTO GEORGE AND ELIZABETH ANN NEUMAN

Surveyed Sept. 23 1974, by D. Dorby