


T.12S., R.6W., W.M.

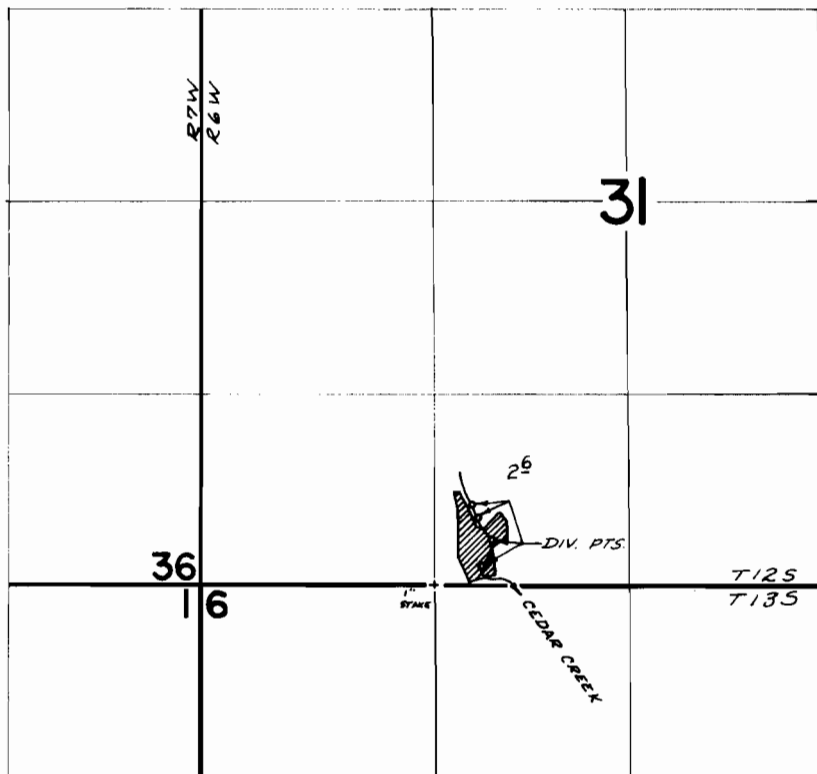

DIV. PTS. LOCATED: 550' N & 260' E
460' N & 300' E
310' N & 390' E
130' N & 320' E; ALL FROM SW COR. SE $\frac{1}{4}$ SW $\frac{1}{4}$ SEC 31.

FINAL PROOF SURVEY UNDER

Application No. **46765** Permit No. **34923**
IN NAME OF

CLAUD E. COATS

Surveyed **Sept. 27** 19**74**, by **D. Norby**