


T.15S.R.6W.W.M.

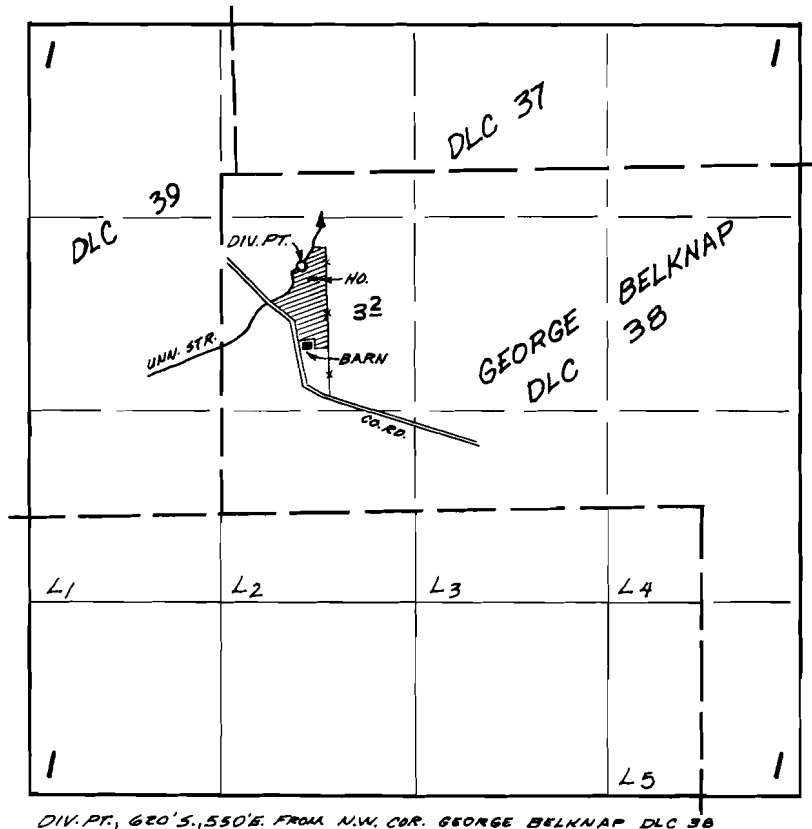

DIV. PT., 620'S., 550'E. FROM N.W. COR. GEORGE BELKNAP DLC 38

FINAL PROOF SURVEY
UNDER

Application No. 47259 Permit No. 35397
IN NAME OF

EARLE E. and ALTA L. BARNTS

Surveyed NOV. 8 1974, by L.M. TOLL