


T.13S., R.6W., W.M.

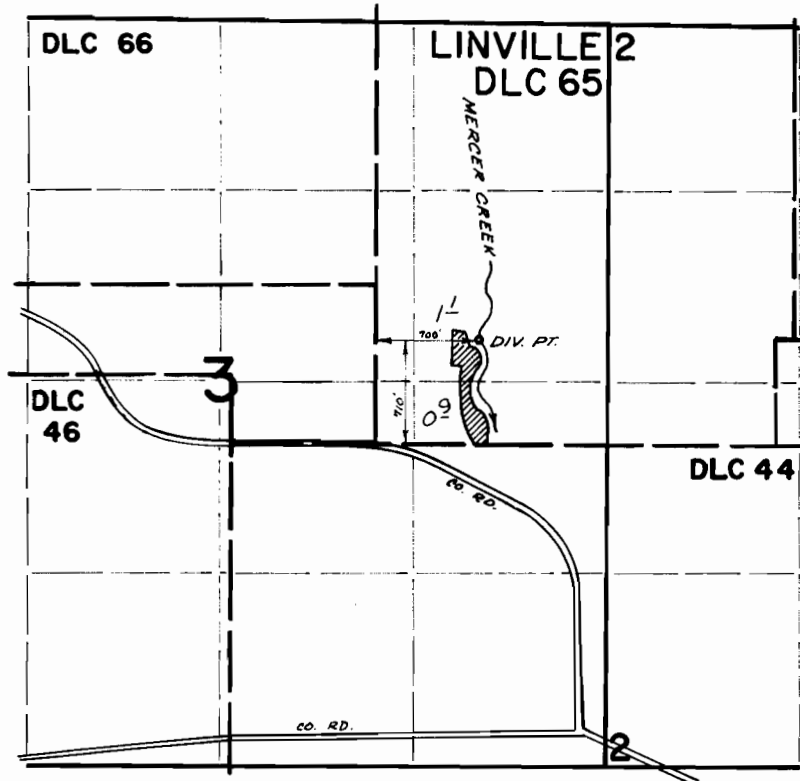

**FINAL PROOF SURVEY**  
UNDER

Application No. **49614** Permit No. **36758**  
IN NAME OF

**W. R. CONLEY**

Surveyed **Sept. 27** 1974, by *D. Dorley*