


T.5N., R.7W., W.M.

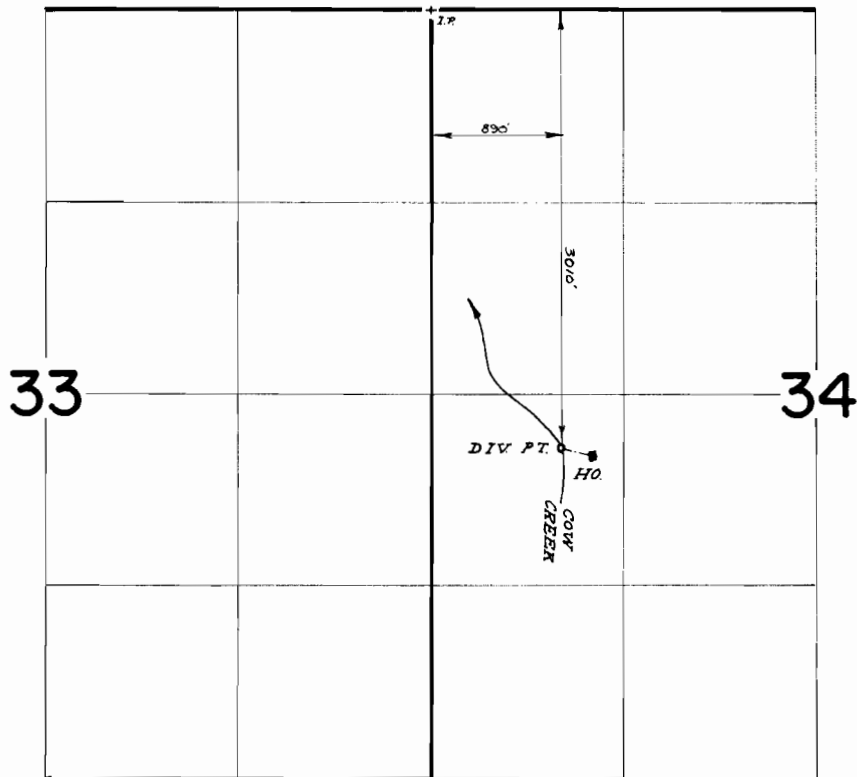

FINAL PROOF SURVEY
UNDER

Application No. 48687 Permit No. 36505
IN NAME OF

JOHN E. KENNEDY

Surveyed June 5 1974, by D. Norby