


T.31&32S. R.15W. W.M.

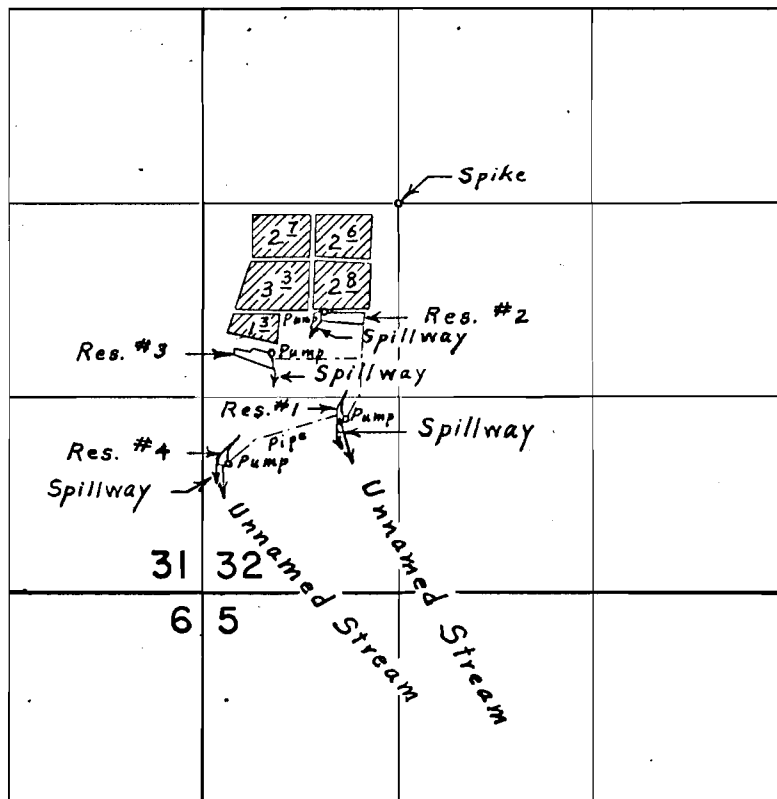

Div. Pts. located: Res. #1, 1500' S. & 380' W.; Res. #2, 780' S. & 380' W.; Res. #3, 1040' S. & 760' W.; Res. #4, 1780' S. & 1196' W. all from N. E. Cor. N.W.  $\frac{1}{4}$  S.W.  $\frac{1}{4}$  Sec. 32

**FINAL PROOF SURVEY**  
UNDER

R-46225                      R-5500  
Application No. 46226    Permit No. 34536  
IN NAME OF

**CHARLES ELLS**

Surveyed Aug. 5, 1974, by L. E. Gould