


T.31&32S. R.15W. W.M.

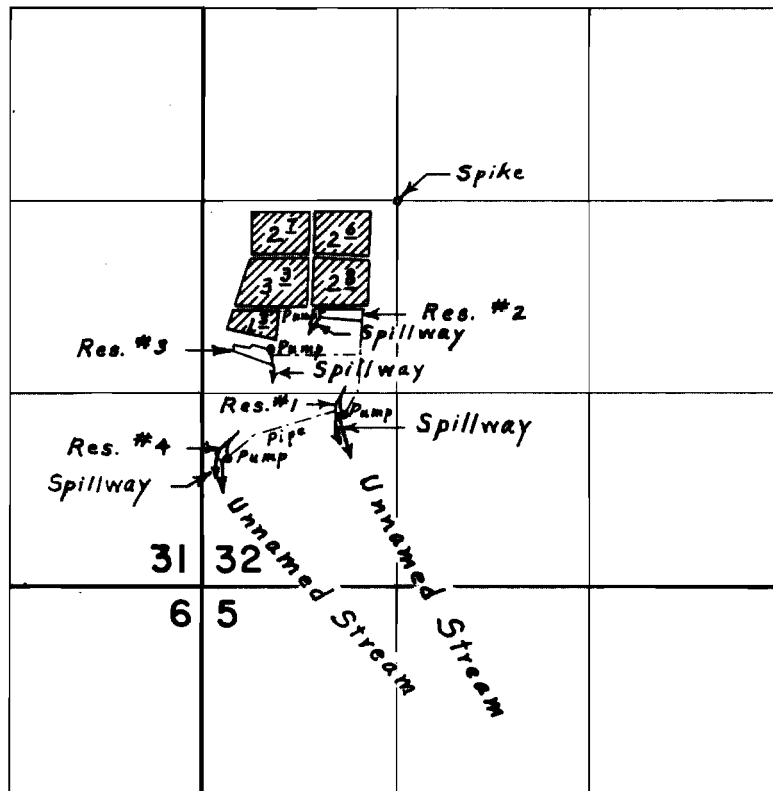

Div. Pts. located: Res. #1, 1500' S. & 380' W.; Res. #2, 780' S. & 380' W.; Res. #3, 1040' S. & 960' W.; Res. #4, 1780' S. & 1190' W. all from N. E. Cor. N.W. & S.W. & Sec. 32

FINAL PROOF SURVEY
UNDER

Application No. R-46225 46226 Permit No. R-5500 34536
IN NAME OF

CHARLES ELLS

Surveyed Aug. 5, 1974, by L. E. Gould