T.31 S. R.15 W. W.M.

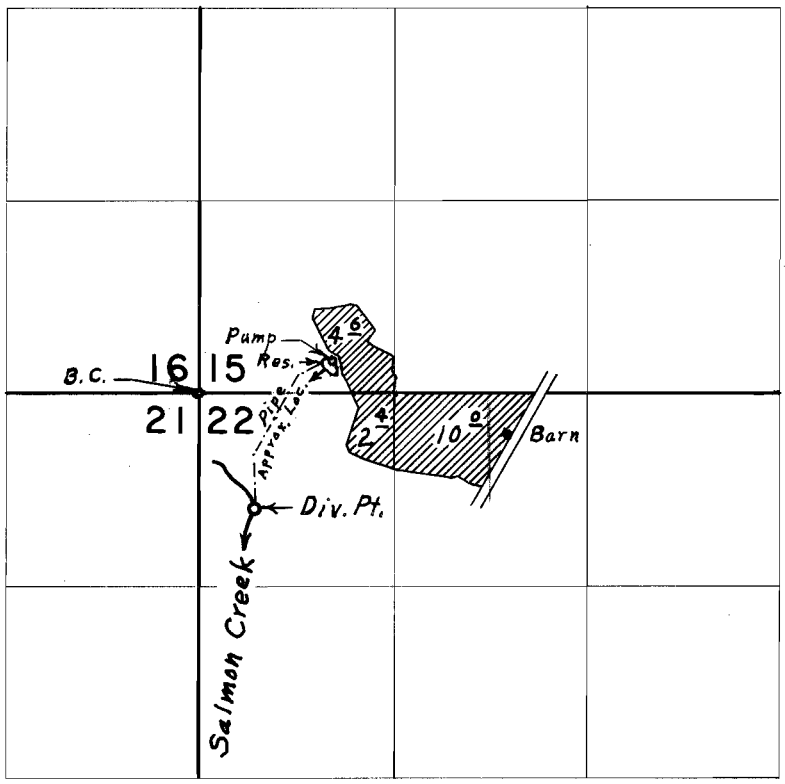

Div. Pts. located: Creek, 800' S. & 380' E.; Res., 180' N. & 840' E.; both from N. W. Corner Section 22

FINAL PROOF SURVEY
UNDER

Application No. R-48464 48465 Permit No. R-5884 36374

IN NAME OF

CHARLES R. JENSEN

Surveyed Aug. 1, 1974, by L. E. Gould

1974-L