


T.31S. R.15W. W.M.

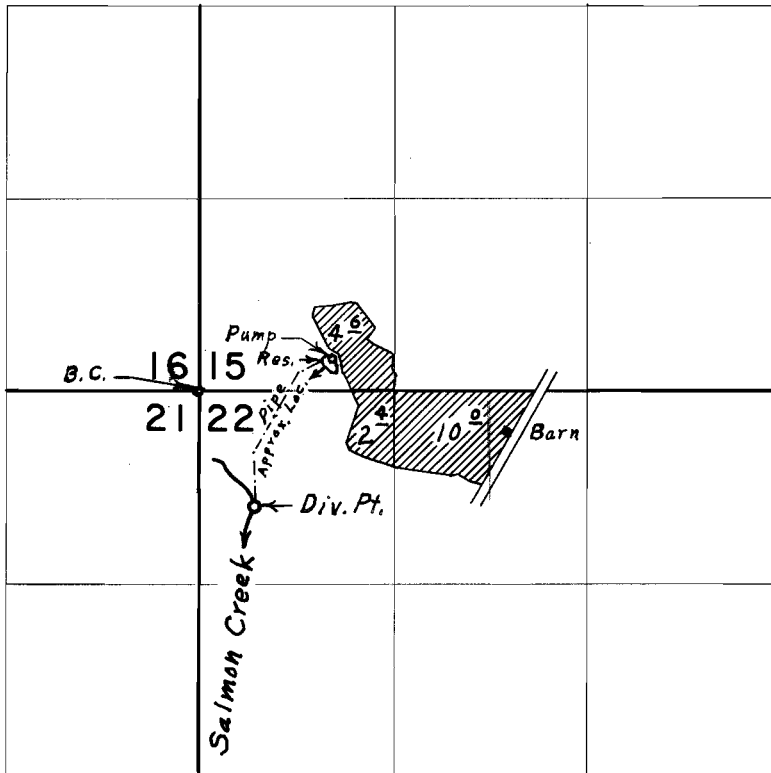

Div. Pts. located: Creek, 800' S. & 380' E.; Res., 180' N. & 840' E.; both from N.W. Corner Section 22

FINAL PROOF SURVEY
UNDER

R-48464 R-5884
Application No. 48465 Permit No. 36374
IN NAME OF

CHARLES R. JENSEN

Surveyed Aug. 1, 1974, by L. E. Gould