


T.31S. R.15W. W.M.

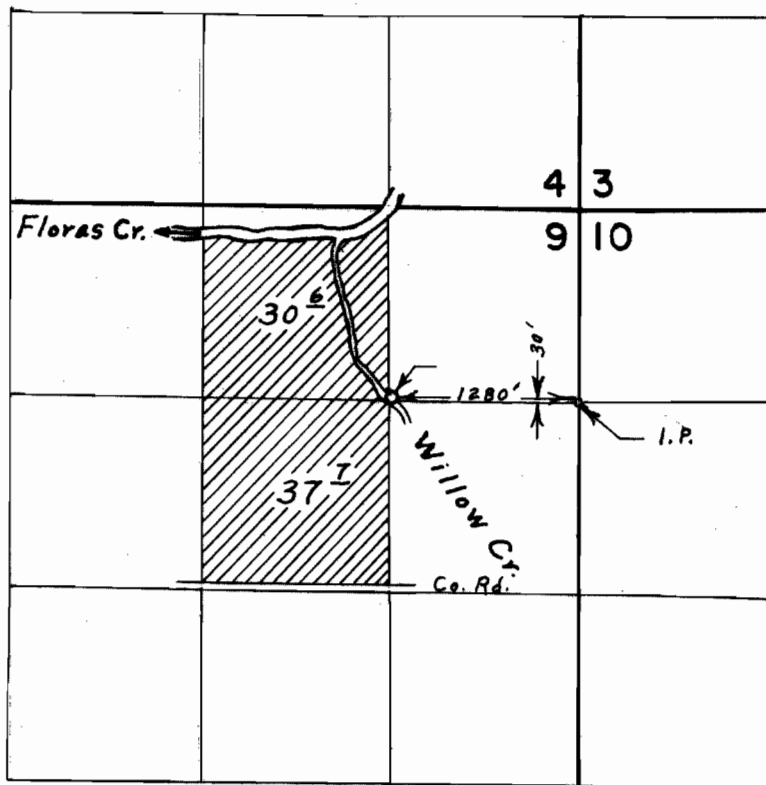

FINAL PROOF SURVEY
UNDER

Application No. 45015 Permit No. 33646
IN NAME OF

NEWTON HAGA

Surveyed July 30, 1974, by L. E. Gould