


T.31S. R.15W. W.M.

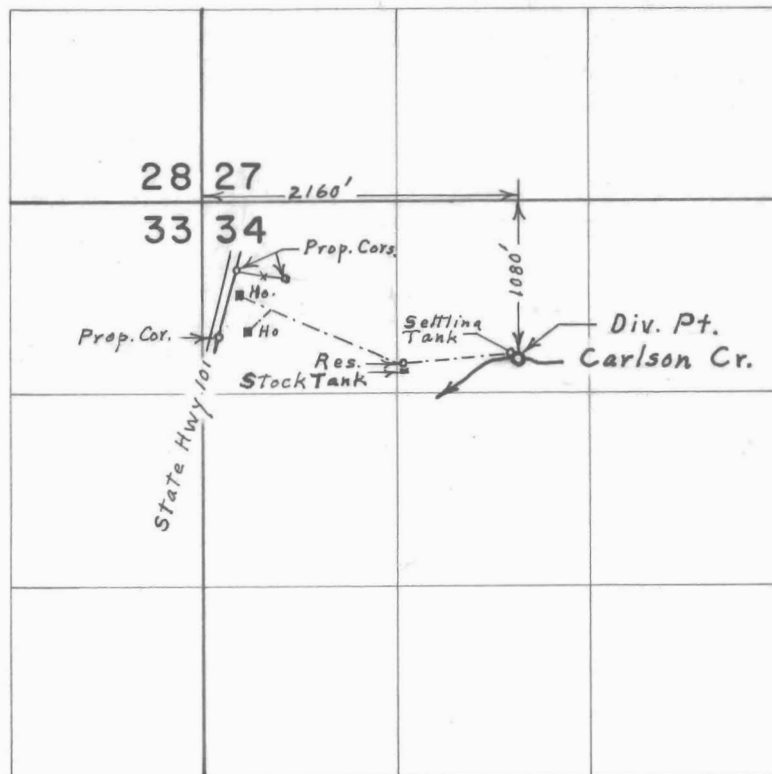

FINAL PROOF SURVEY
UNDER

Application No. 49652 Permit No. 37180...
IN NAME OF

ANDREW S. & ALICE FAY CARLSON

Surveyed Aug. 1, 1974, by L. E. Gould