


T.22&23S.R.4W.W.M.

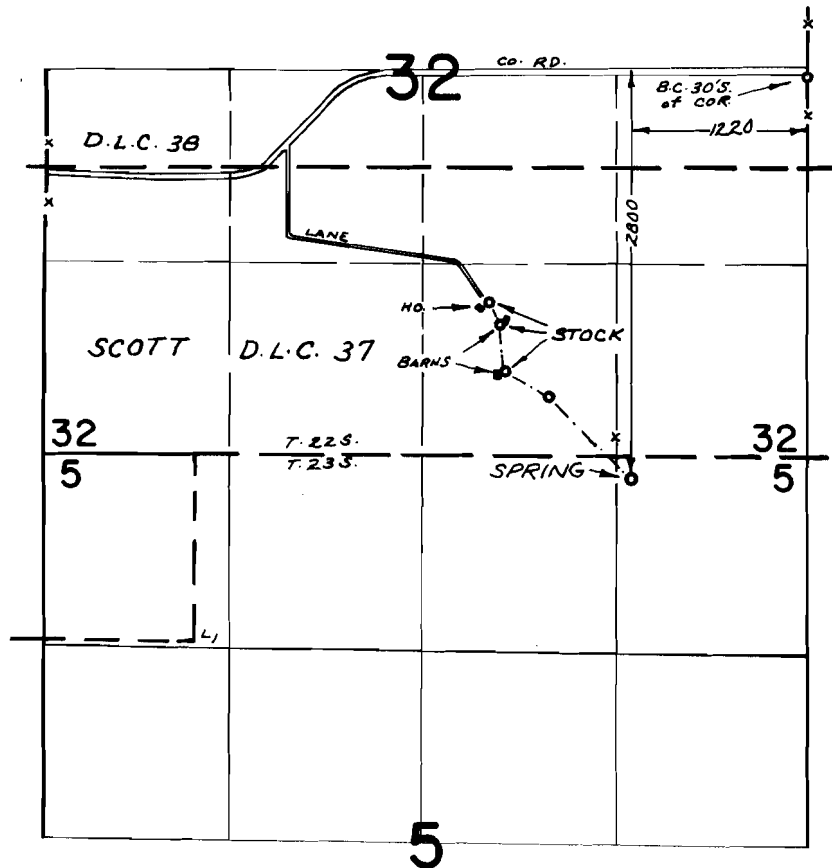

FINAL PROOF SURVEY
UNDER

Application No. 45525 Permit No. 33972
IN NAME OF

CLEMENT H. NUSS

Surveyed OCT. 17, 1974, by R. MUCKEN