


# T.22S.R.7W.W.M.

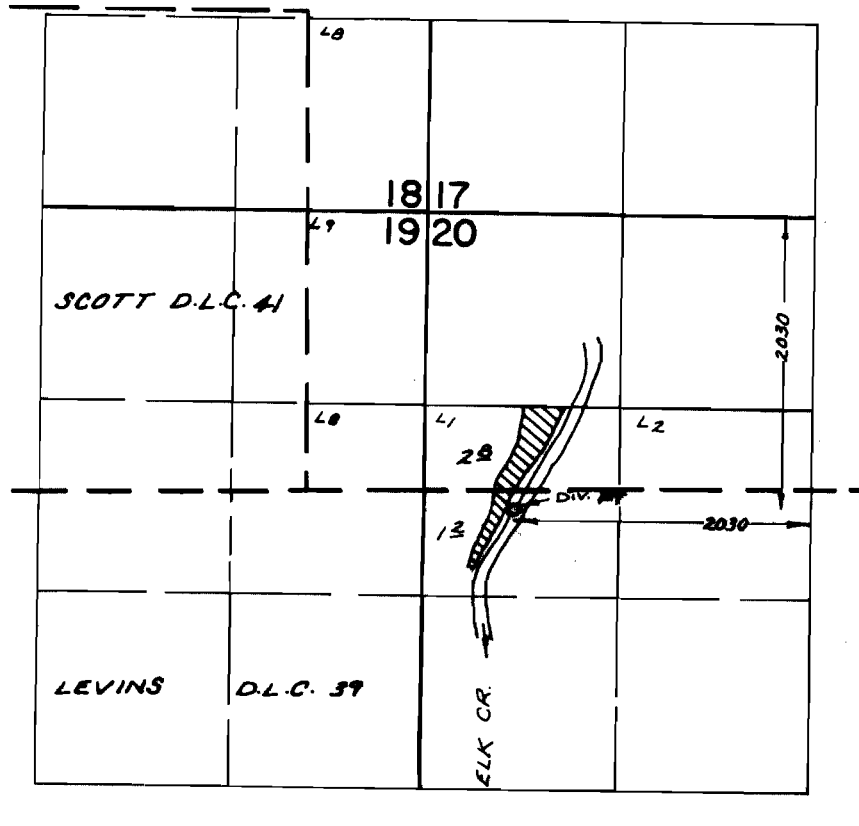

## FINAL PROOF SURVEY UNDER

Application No. ~~46676~~..... Permit No. ~~34656~~.....  
IN NAME OF

.....JOYCE.....E.....BLAKE.....

Surveyed MAY 1, 1974, by R. MUCKEN