


T.29S. R.4W. WM

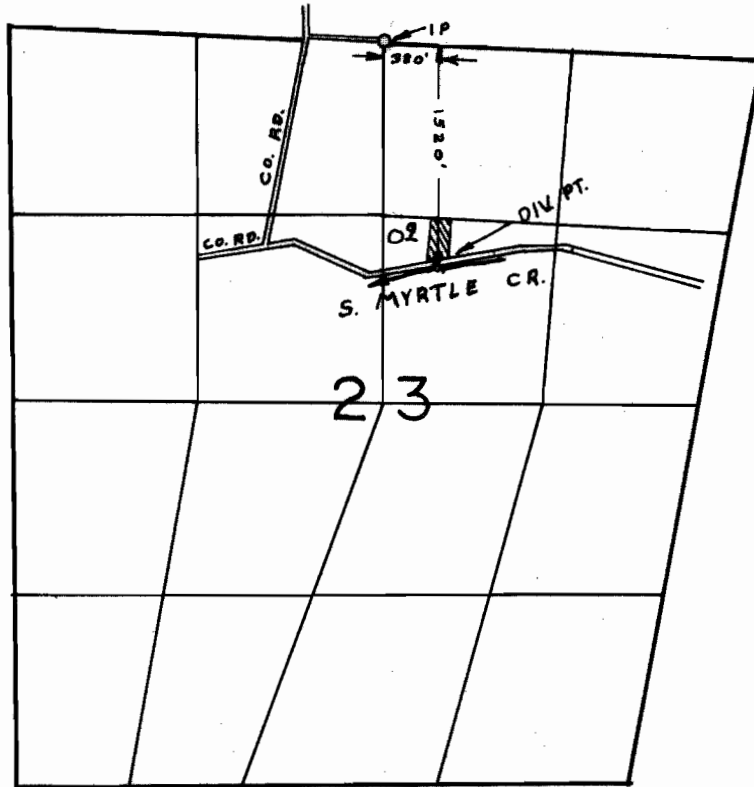

FINAL PROOF SURVEY
UNDER

Application No. 47532 Permit No. 35071
IN NAME OF

T. A. THOMPSON

Surveyed JULY 9 1974, by L. H. NUNN