


T. 29 S. R. 4 W. W.M.

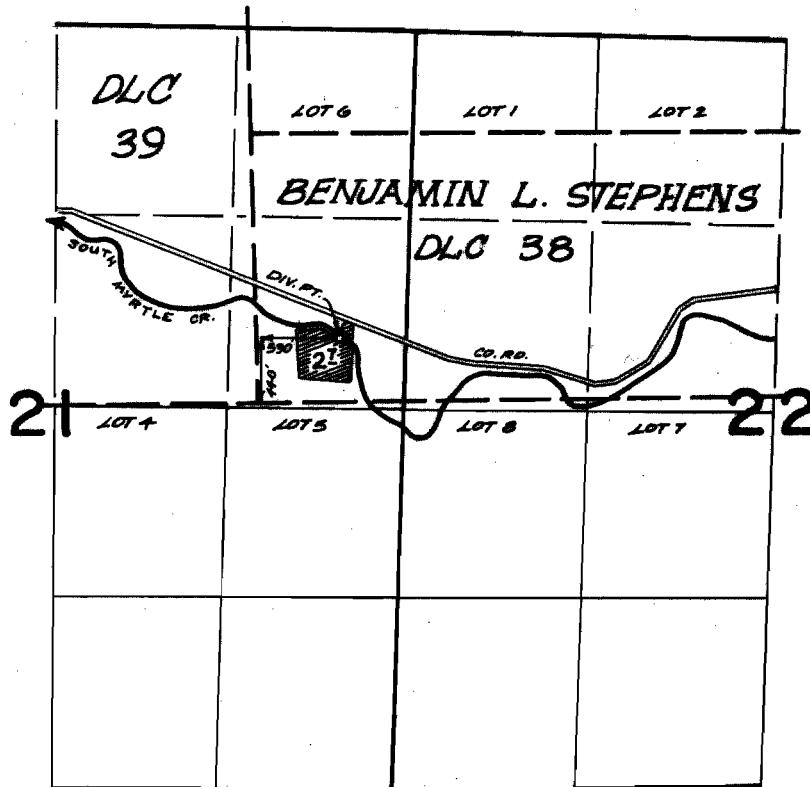

**FINAL PROOF SURVEY**  
UNDER

Application No. 47449 Permit No. 35548  
IN NAME OF

LUTHER C. HARRIS

Surveyed JUNE 18 1974, by P. NORBY