


T. 28 S. R. 6 W. W.M.

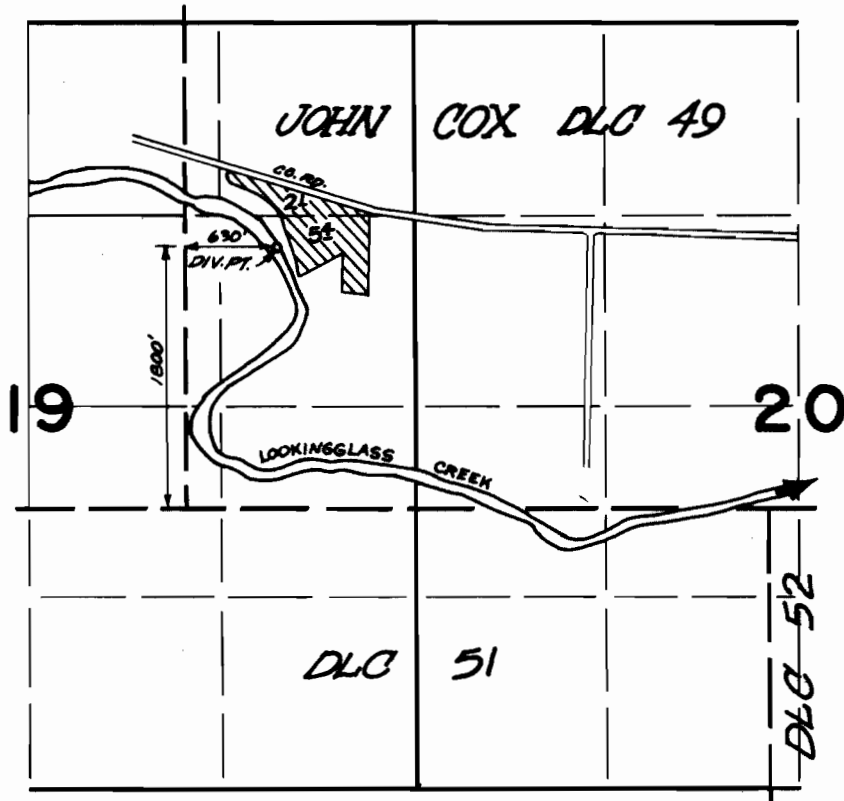

FINAL PROOF SURVEY
UNDER

Application No. 48705 Permit No. 36545
IN NAME OF

LYNN E. ROSS & WARREN HOUSEHOLDER

Surveyed JUNE 17, 1974, by D. NORBY.....