


T.30S. R.6W. W.M.

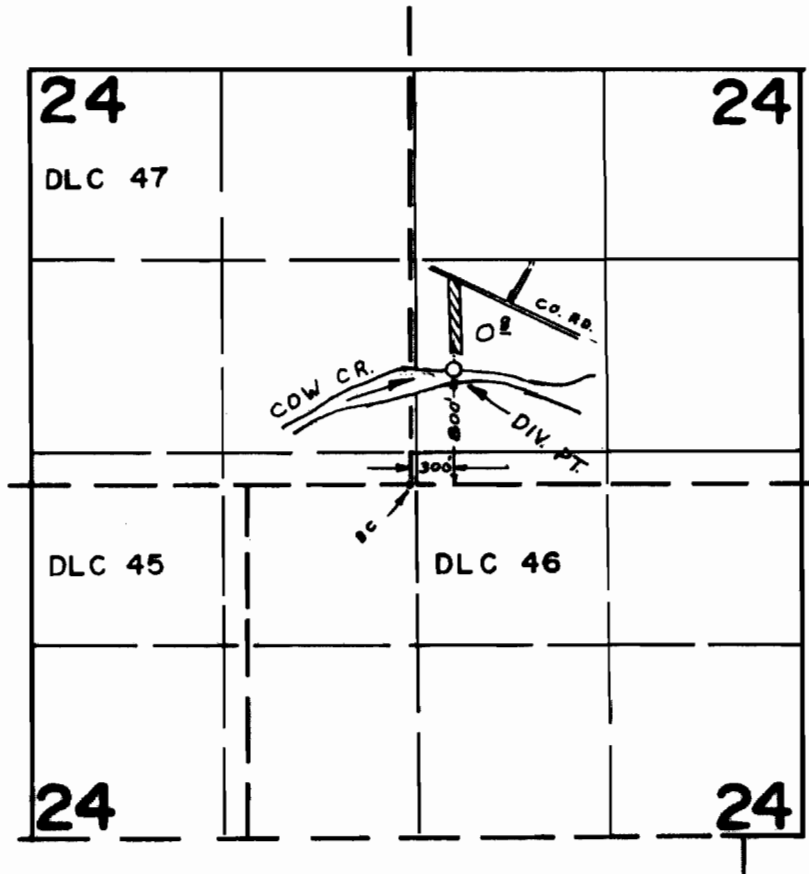

FINAL PROOF SURVEY UNDER

Application No. 42408 Permit No. 37024
IN NAME OF

LEONARD WADDLE

Surveyed JULY 9 1974, by L. H. NUNN