


# T.26 S. R.3 W. W.M.

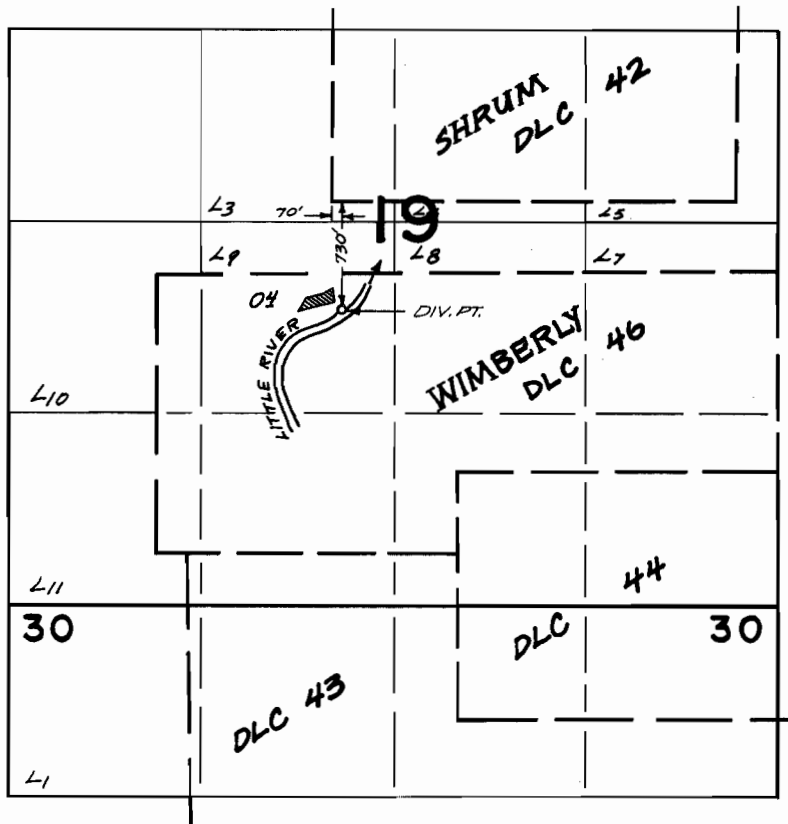

## FINAL PROOF SURVEY UNDER

Application No. 50516 Permit No. 37159  
IN NAME OF

MARVIN R. & VIVIAN G. KAHN

Surveyed JUNE 19, 1974, by L.M. TOLL