


T.18 S. R.28 E. W.M.

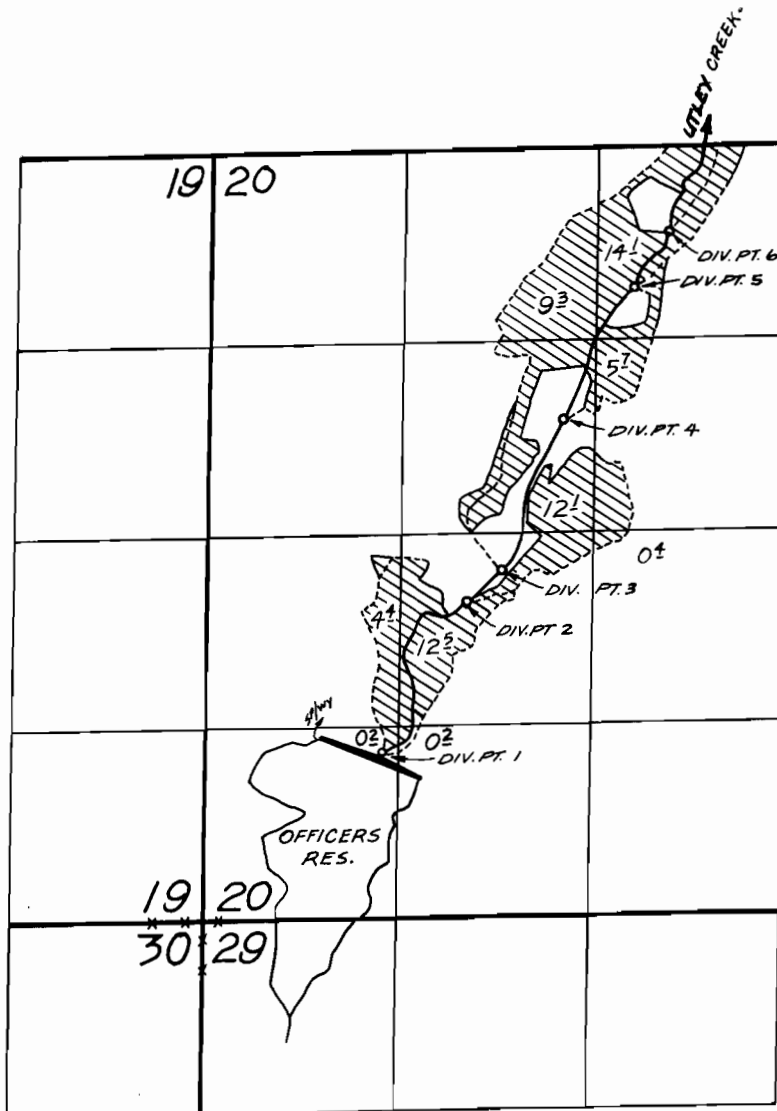

DIV. PTS LOCATED; 1, 1170' N. & 1230' E. 2, 2200' N. & 1810' E.
 3, 2400' N. & 2050' E. 4, 3450' N. & 2470' E. 5, 4370' N. & 2960' E.
 6, 4740' N. & 3200' E. ALL FROM S.W. CORNER SECTION 20.
 DAM LOCATED; 1150' N. & 1220' E FROM S.W. CORNER SECTION 20.

FINAL PROOF SURVEY UNDER

TRANSFER No. O-51
 R 42241 R4933
 Application No. 42242 Permit No. 32260
 IN NAME OF

OFFICERS RANCH INC.

Surveyed OCTOBER 3 1974, by D. NORBY