


T.13&amp;14S. R.33E. W.M.

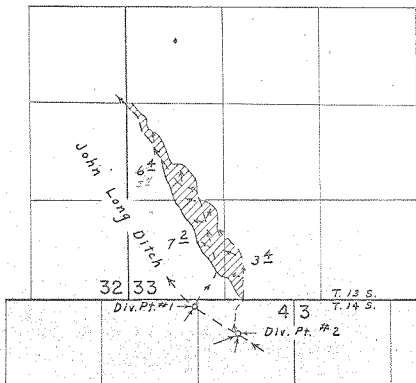

Div. Pts. located: #1, 90° S. & 92.0° E.; #2, 46.0° S. & 149.0° E.  
both from S. W. Corner Section 33

### FINAL PROOF SURVEY UNDER

Application No. 37686 Permit No. 28273  
IN NAME OF RAY BROTHERS

Surveyed June 10, 1977, by L. E. Gould