


T.36S.R.11 & 12E.W.M.

Sprague R. wells

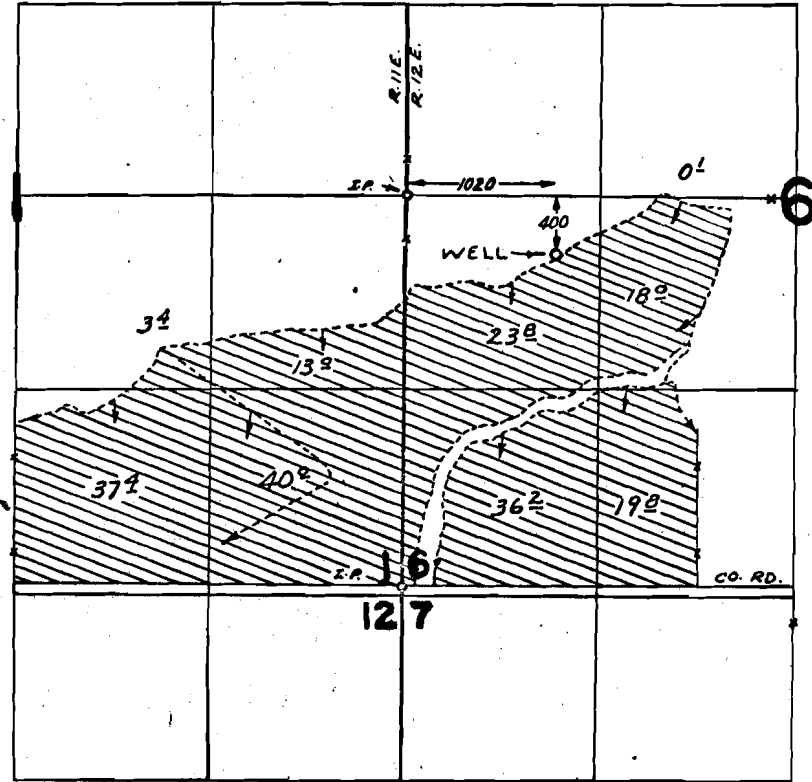

FINAL PROOF SURVEY UNDER

Application No. ~~G-3232~~ Permit No. ~~G-3632~~
IN NAME OF

.....ERNEST D. FIRSICK.....

Surveyed OCT. 23, 1974, by R. MURKEN.