


T.36S.R.11E.W.M.

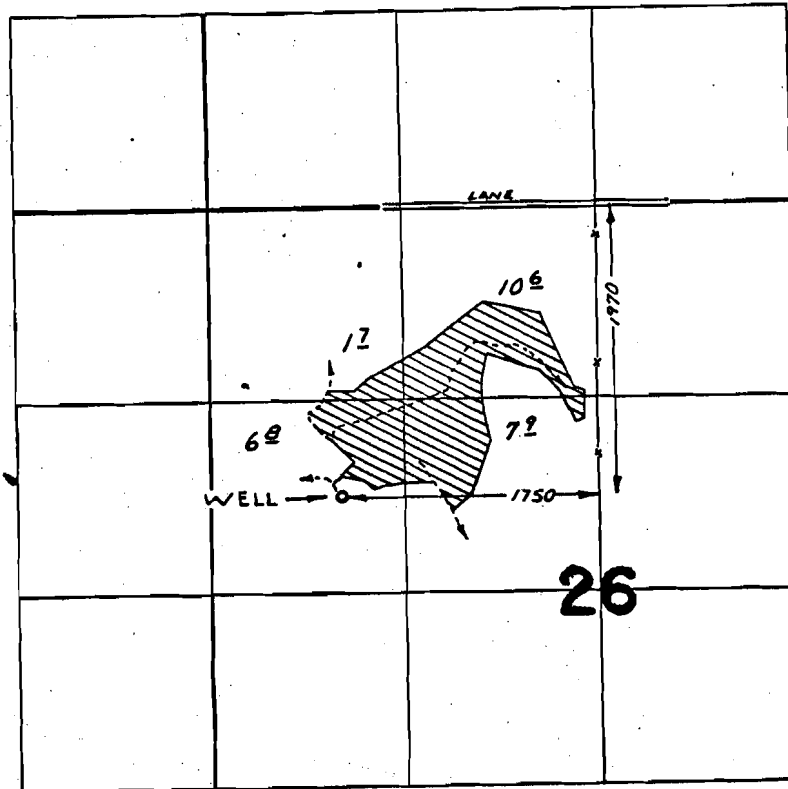

Sprague Av. Wells

FINAL PROOF SURVEY UNDER

Application No. G-4334 Permit No. G-4089
IN NAME OF

DANIEL J. & YOLANDA R. ROSSI

Surveyed Oct. 25 1974, by R. MUCKEN