G-4552
42502

T.38S., R.11 1/2E., W.M.

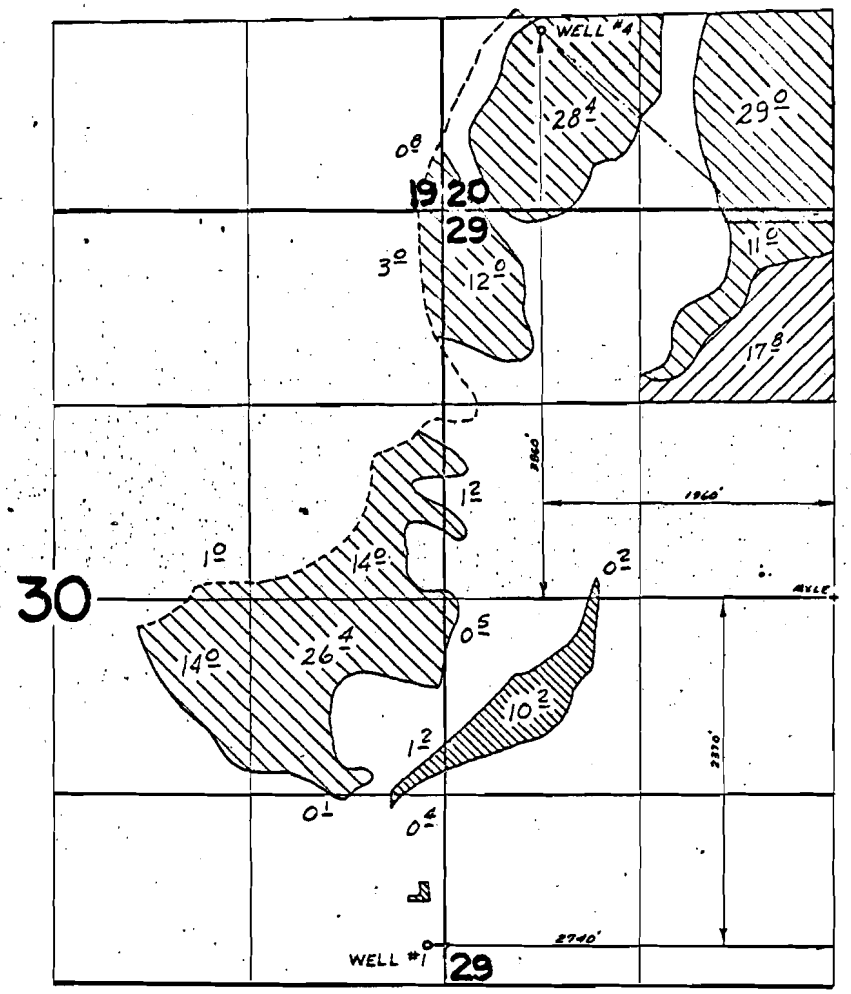

PRIMARY WELL #1
PRIMARY WELL #4
SUPPLEMENTAL WELL #4

Swan Lake wells

FINAL PROOF SURVEY
UNDER

Application No. G-4812 Permit No. G-4552
IN NAME OF

MELVIN W. McCOLLUM

Surveyed Oct. 28 1974, by D.M. Norby

CNO-3JJ-17