


T.38S., R.11 1/2E., W.M.


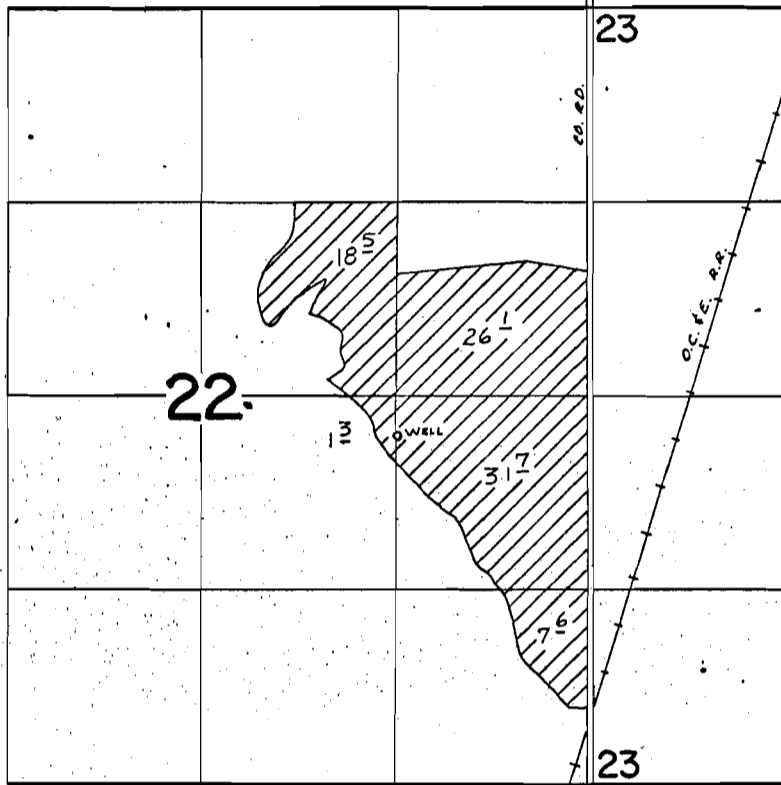

WELL LOCATED: 1590' S & 20' E FROM NE COR. SW 1/4 NE 1/4 SEC. 22

FINAL PROOF SURVEY UNDER

Application No. G-5279 Permit No. G-5121
IN NAME OF

CLIFF SEWALD

Surveyed Oct. 23 1974, by D.M. Norby